



## CITY OF ALEXANDRIA Project Implementation



# Waterfront Flood Mitigation Project Discussion

June 23, 2025

Draft, Deliberative, Pre-Decisional




# AWA Alternative Concept: Stated Objectives

- 1) Reduce the size & footprint of the pump station
- 2) Reduce community impacts

## Alexandria Waterfront Alliance

### Flood Mitigation Alternatives 7/3/25

1. Replace exist. outdated storm sewers and drain directly to the river ———→
2. Deployable flood barrier at N Union ———
3. Elevate bathtub streetscape to 4' where possible & drain to pump ———→
4. Reocated pump station ■■■■
5. Delete proposed new Union St. pipes - - - - -

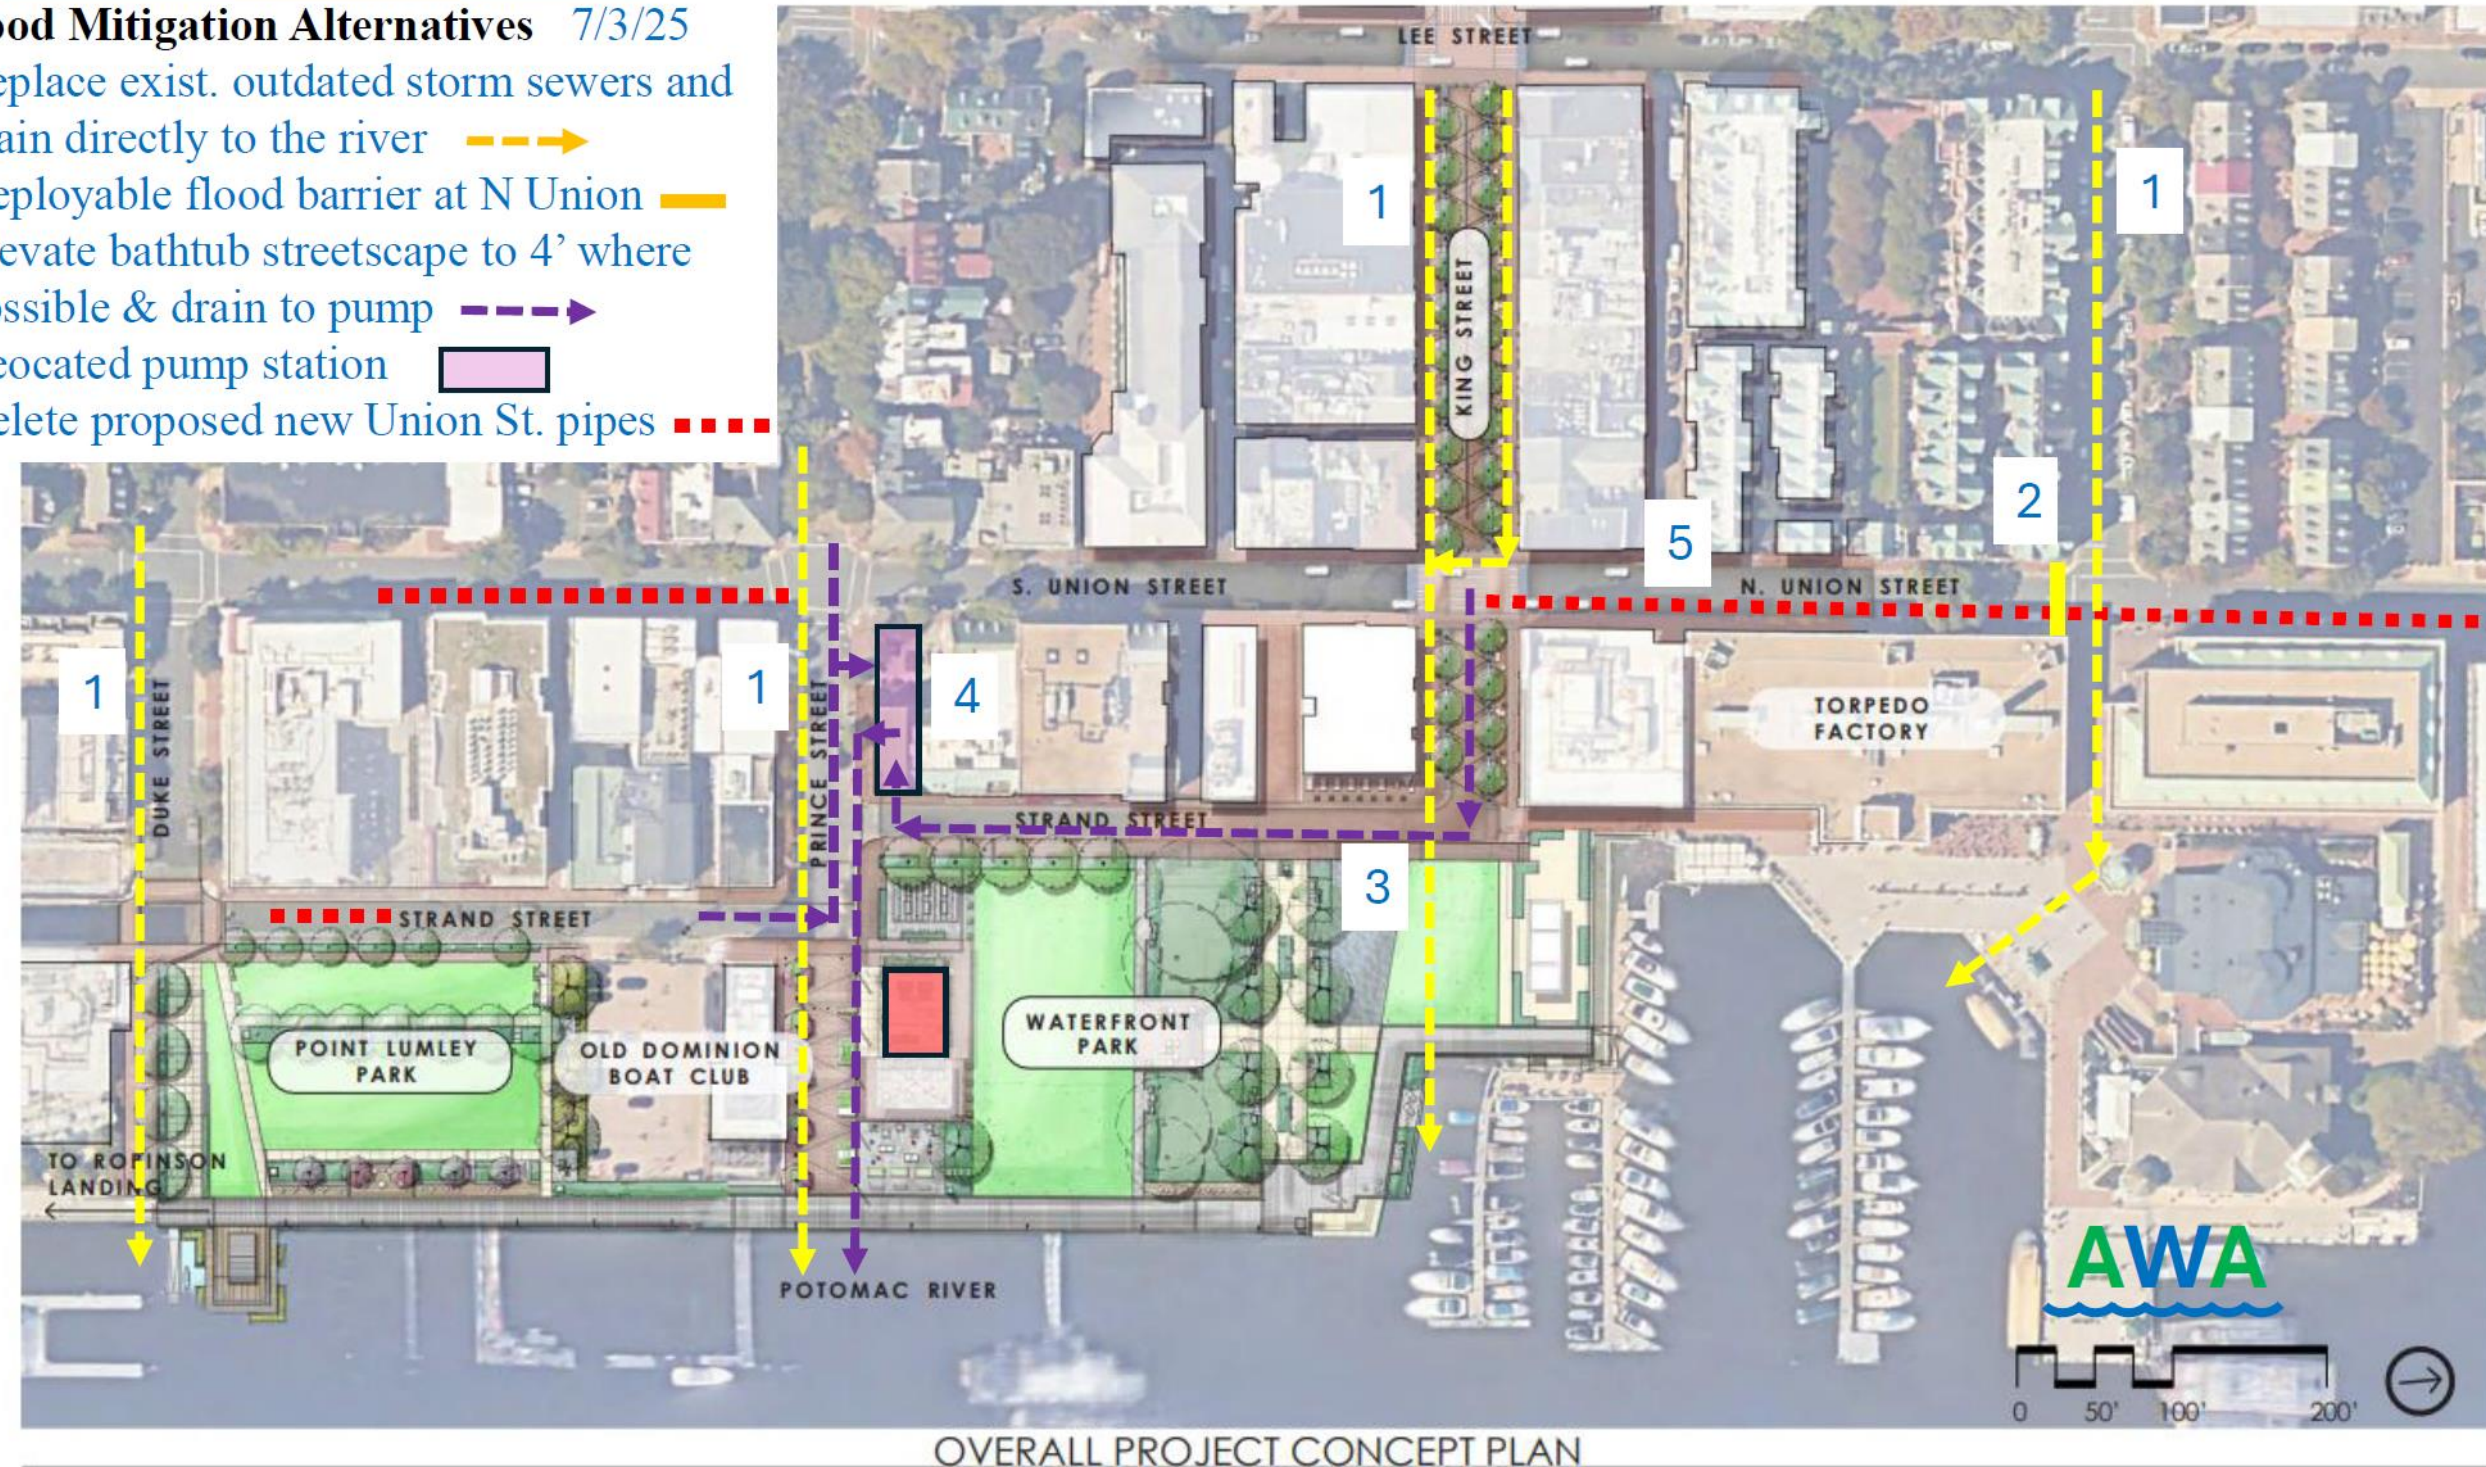


\* Conceptual Drawing credit: Mr. Al Cox, AIA 7/3/2025. Subsequent sheets include markups and notes by the City of Alexandria



# AWA Alternative Concept

This theoretical concept proposes a dual stormwater system which, after evaluation by engineering analysis and modeling:

- **Does not substantially reduce the footprint/size of the pump station**
- **Increases construction impacts as compared to the City's current proposal:**
  - Would require deep excavations and deeper outfall structures than is feasible/sustainable
  - Would still requires phased street closures
  - Would likely increase utility conflicts and disruption due to relocations
  - Would likely increase construction impacts to residential areas and park areas (including Founder's Park)
- **May increase overall project and construction costs**

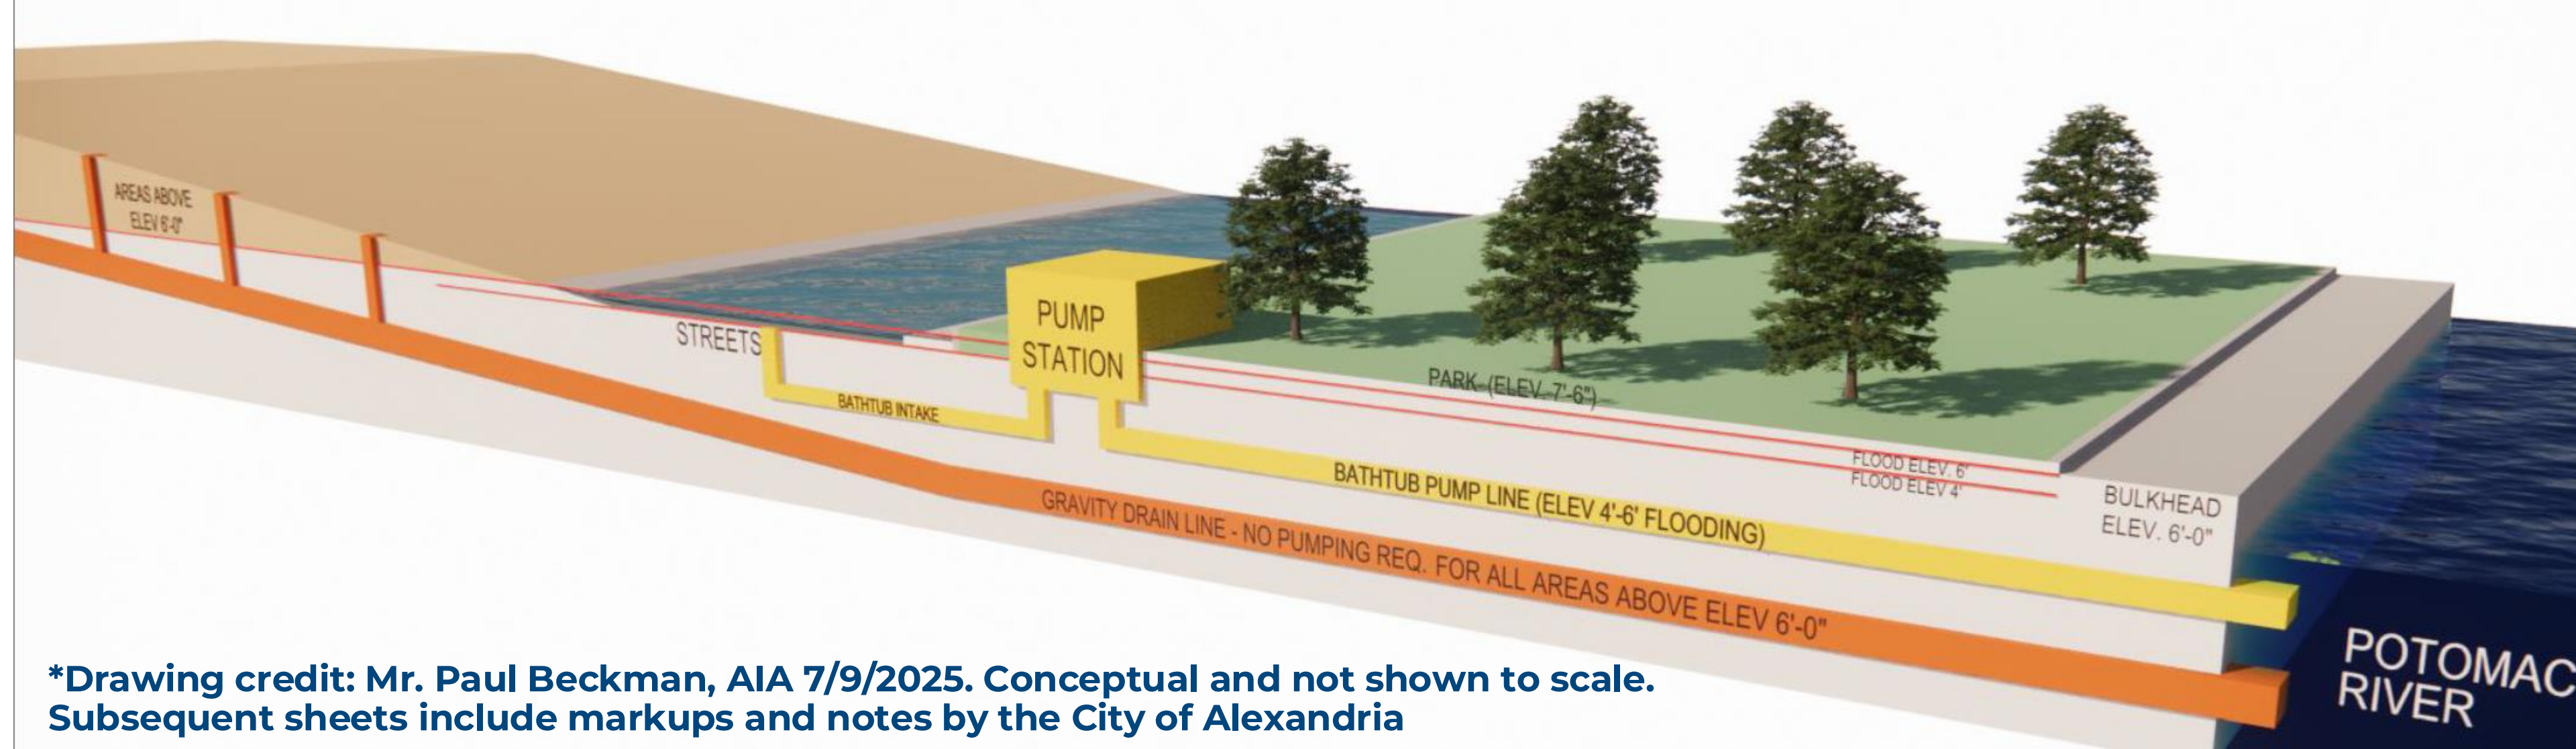


\*Drawing credit: Mr. Paul Beckman, AIA 7/9/2025. Conceptual and not shown to scale.  
Subsequent sheets include markups and notes by the City of Alexandria



# AWA Alternative Concept: Pump Station Size Constraints


## Waterfront Park Pump Station

### Explaining the Numbers

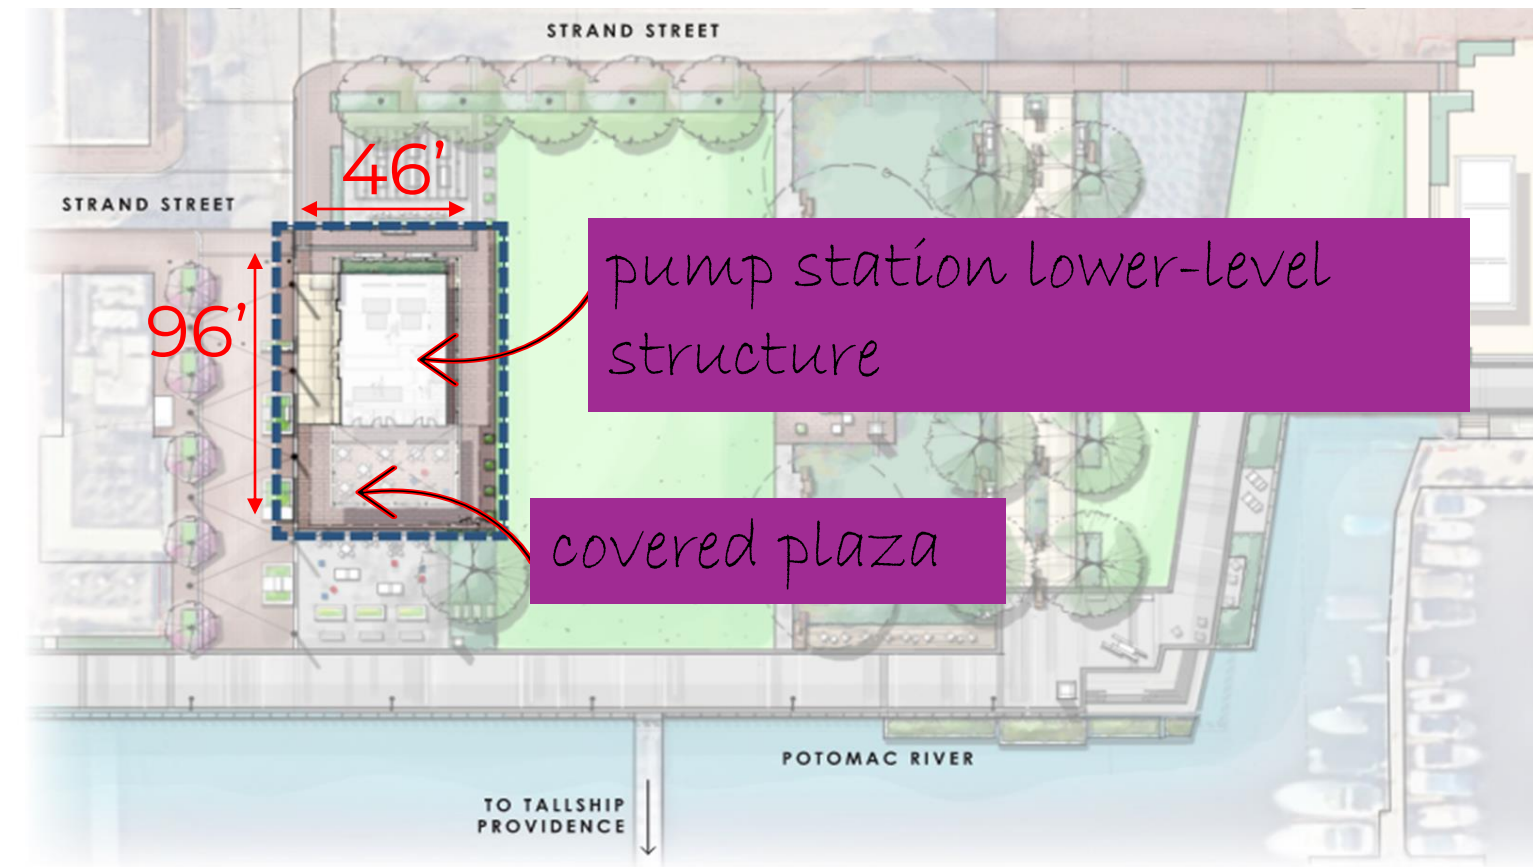

The Pump Station footprint is approx. 96' x 46' (4,420 SF).

On the lower level, the footprint includes a covered plaza supporting a portion of the second story.

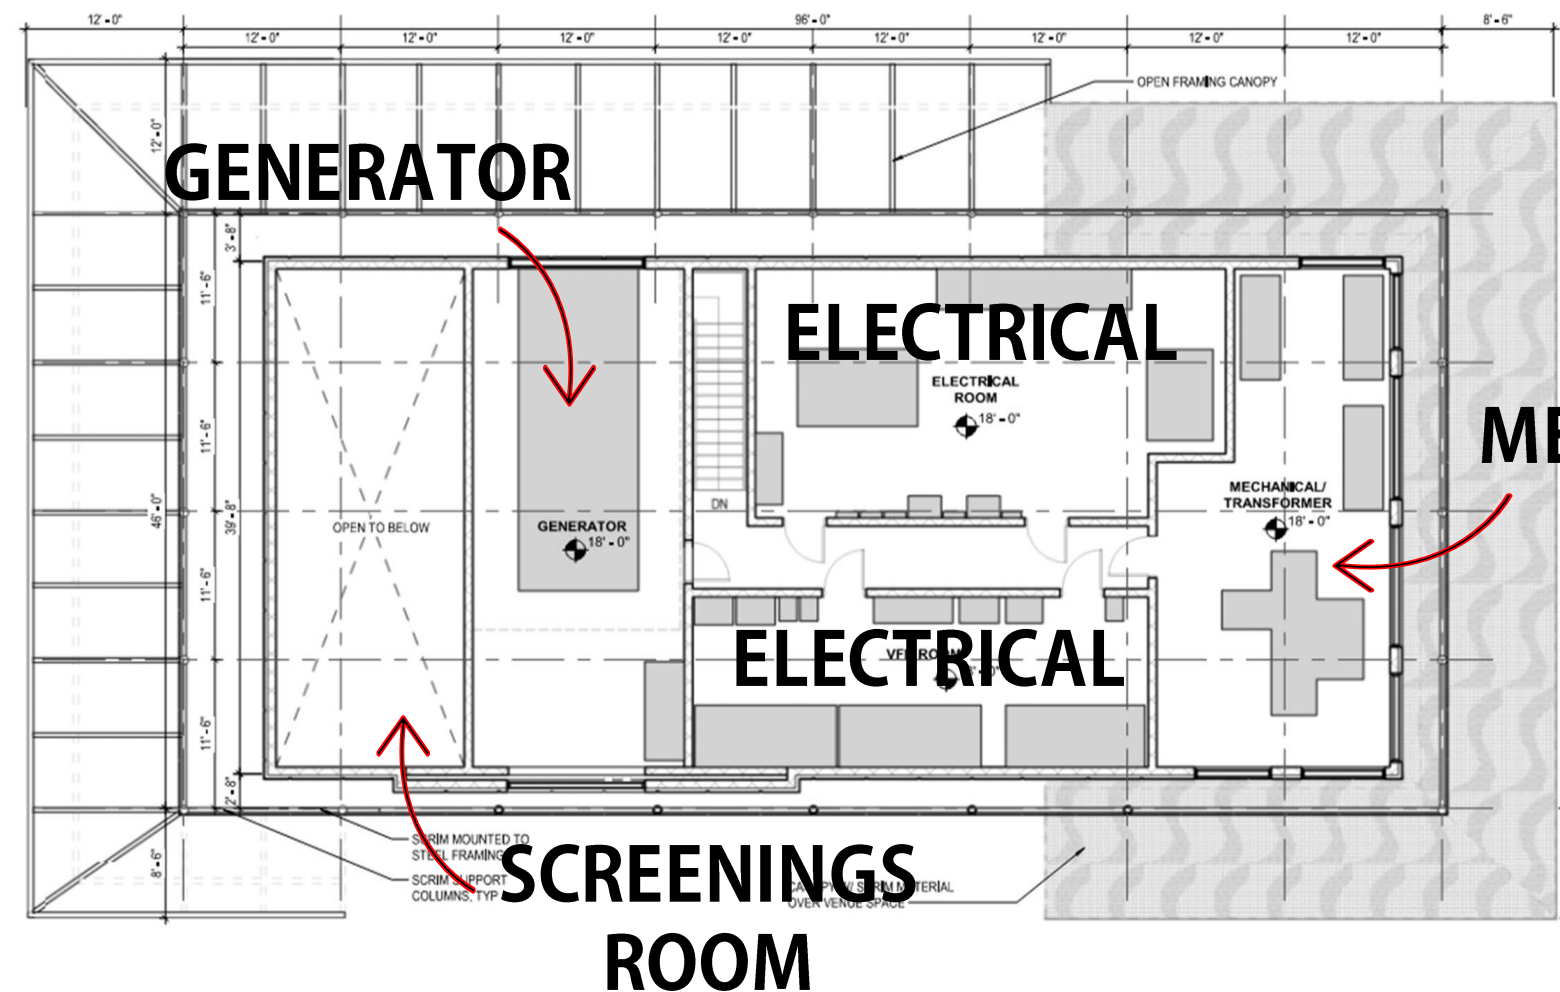

### MECHANICAL/ HVAC


The second floor sets the building footprint.

These rooms are fundamental to the operation of any pump station, regardless of flow/capacity.

# AWA Alternative Concept: Pump Station Size Constraints

Minimum Clearance Requirements per NEC and/or Equipment Manufacturer

Meeting the requirements prevents the 2<sup>nd</sup> floor from being reduced, even with the elimination of a VFD Pump Controller.

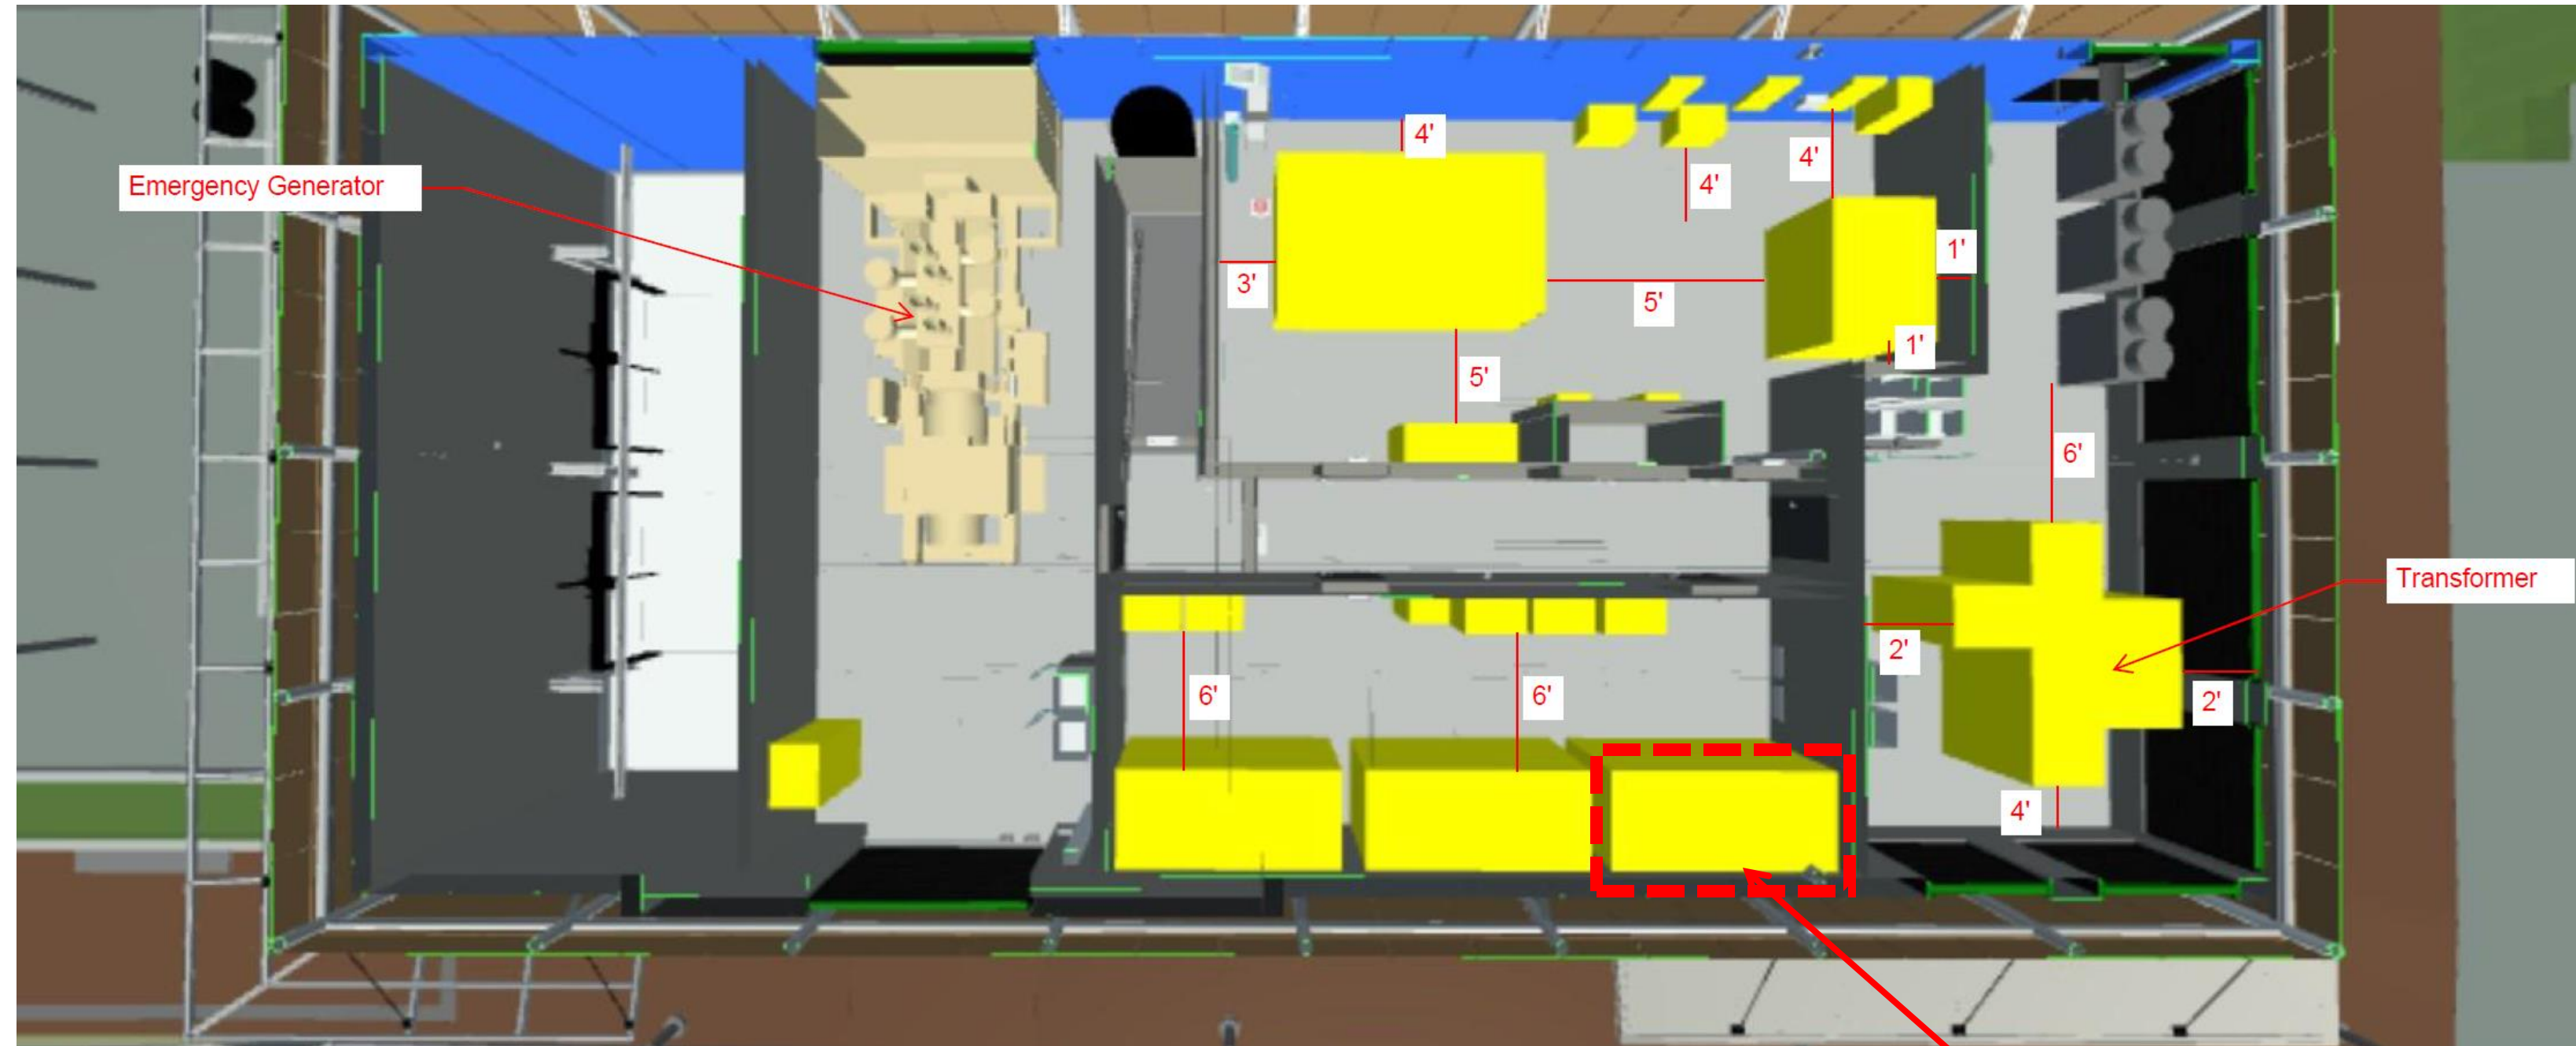


Even if we could reduce pump station pumping capacity by 50% (to ~ 115 MGD) - only one Pump/**VFD Pump Controller** would be eliminated.  
**This will not substantially reduce the size of the pump station as suggested by AWA.**



# Impacts of AWA Alternate Concept

This approach would be more impactful than the City's proposal.  
Would still require deep excavation, long-term street closures, and additional impacts to street ends and park areas (including Founder's Park)

- Increased impacts to Cameron Street/Queen Street and intersections with Union Street
- Deep/wide excavation between Torpedo Factory and ALX Comm. (risk to foundations)
- Increased impacts to Founders Park
- Conflicts between gravity by-pass, existing utilities, and proposed storm pipes
- More impacts in some streets due to dual system (2x pipes running through streets)
- Deep outfalls – Costly and impactful to construct. Difficult maintain post-construction

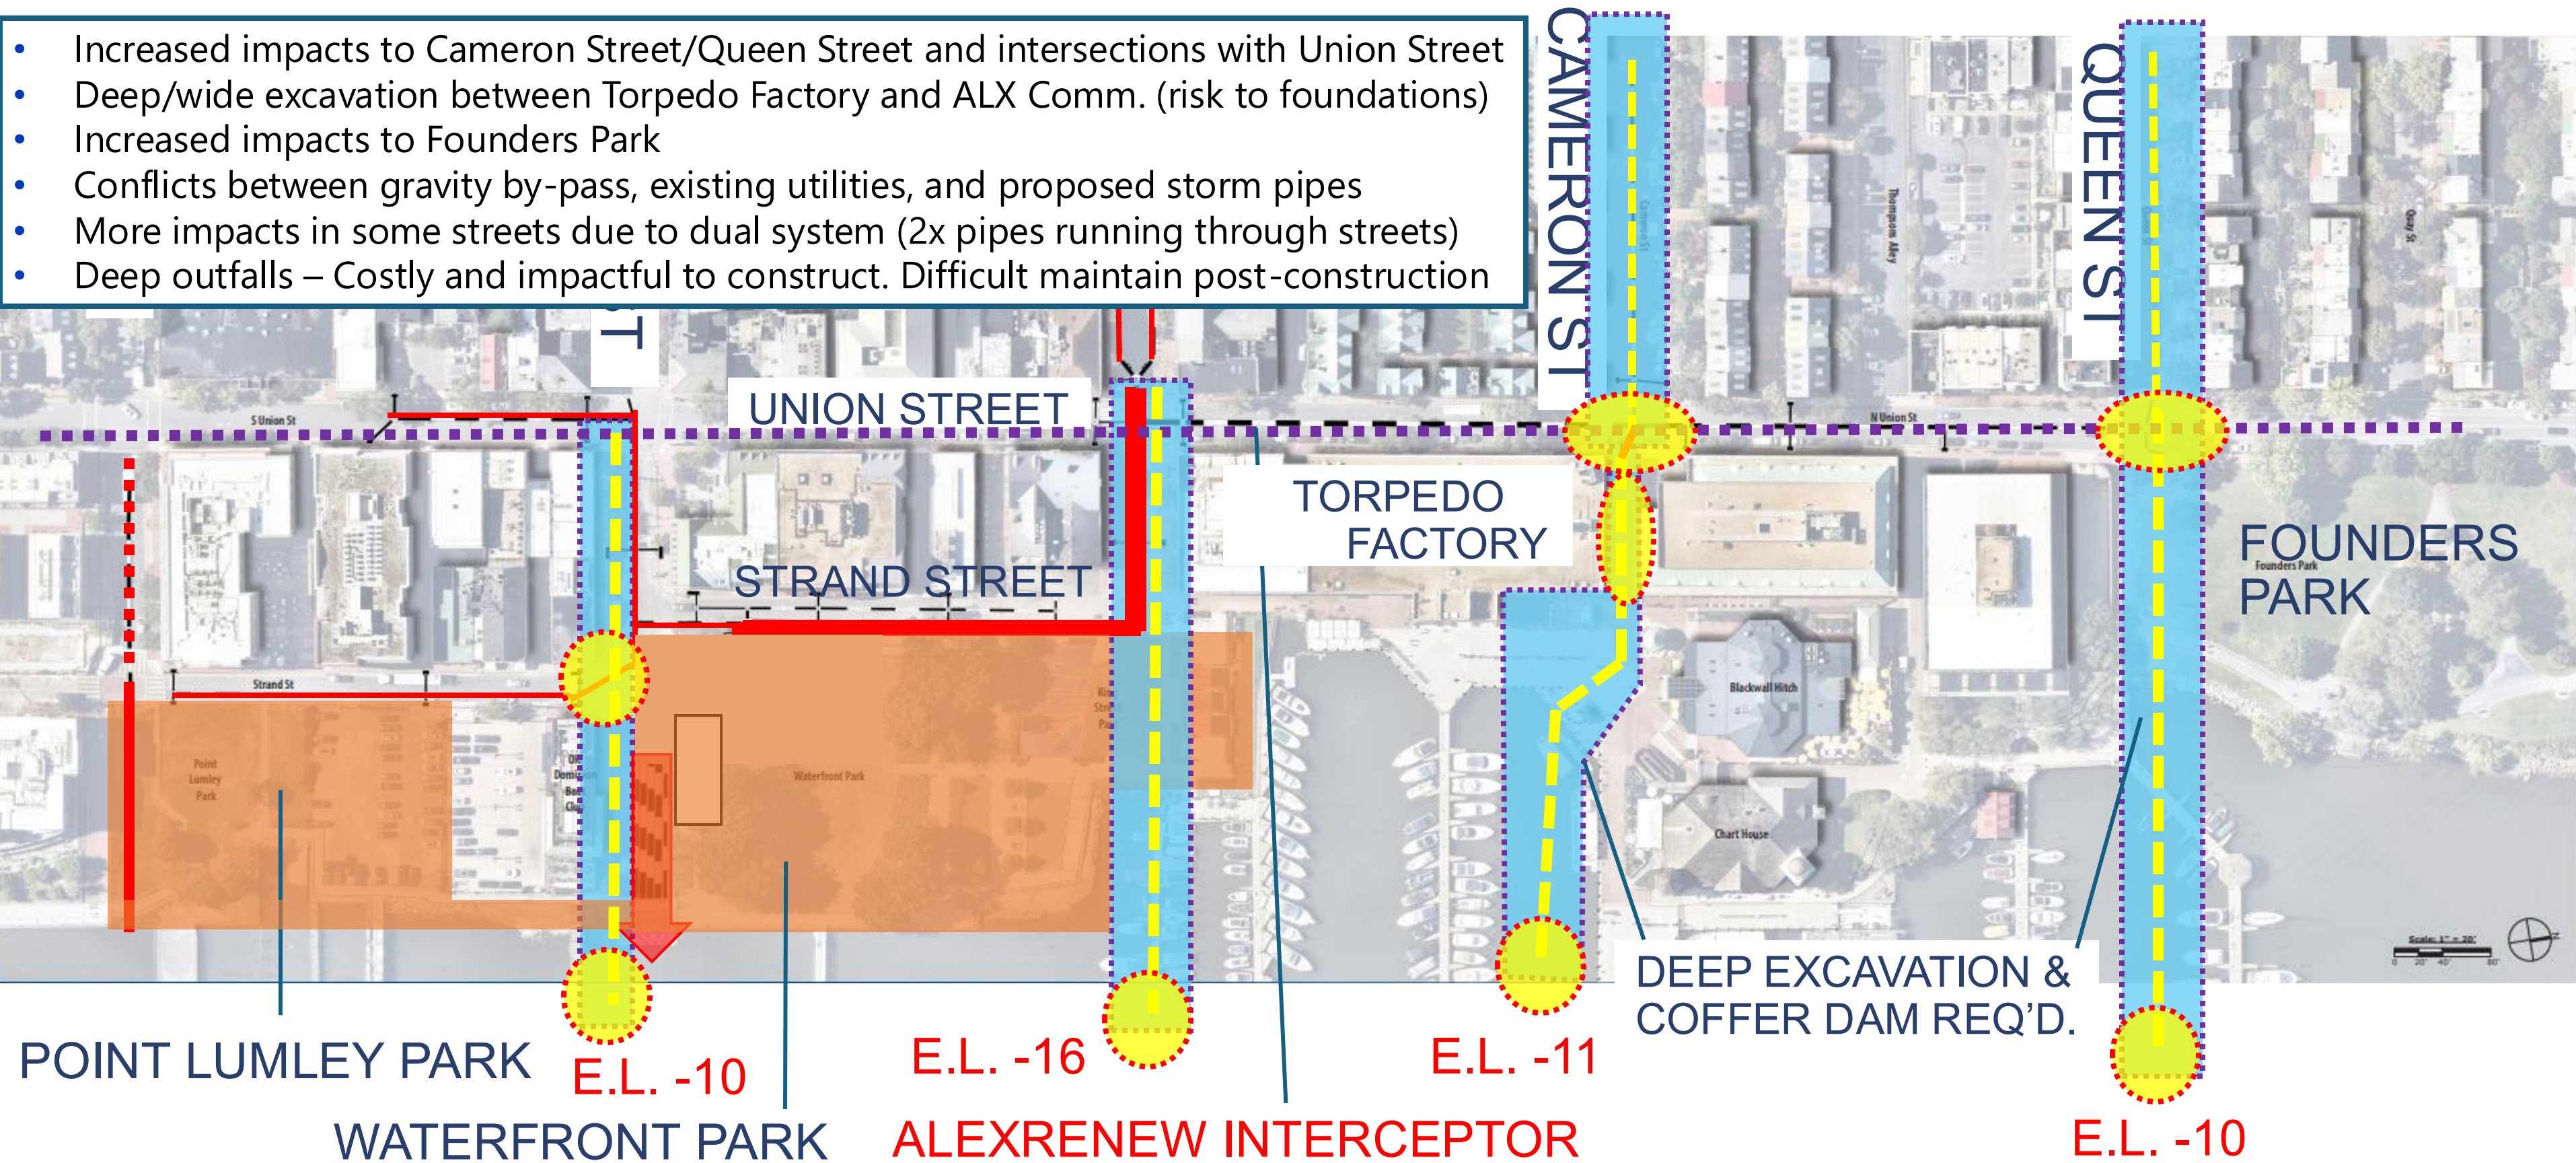



# Impacts of AWA Alternate Concept: Deep Excavation and Cofferd Dam (example)






# AWA Alternative Concept: Capacity Constraints




Rainwater runs downhill in rainstorm...

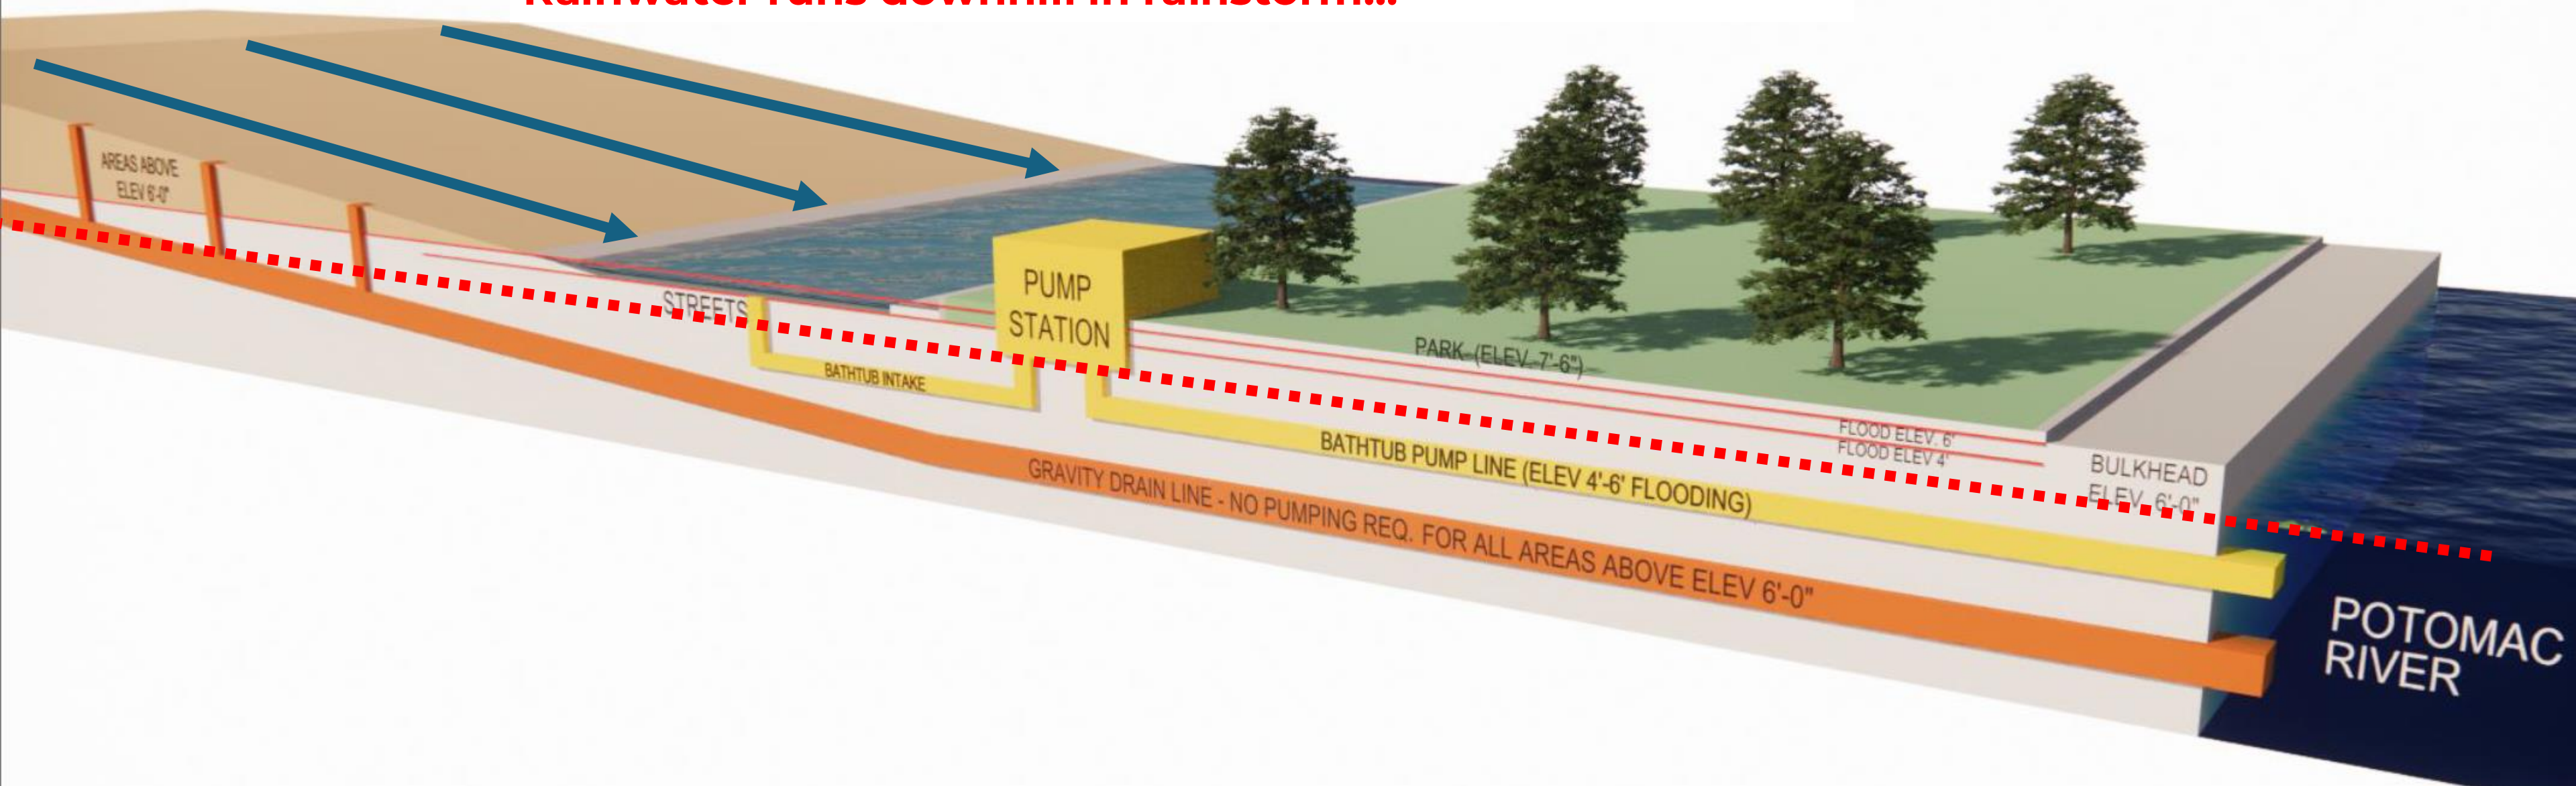

\*Underlying drawing credit: Mr. Paul Beckman, AIA 7/9/2025. Conceptual and not shown to scale. Additional markups by City of Alexandria.




# AWA Alternative Concept: Capacity Constraints

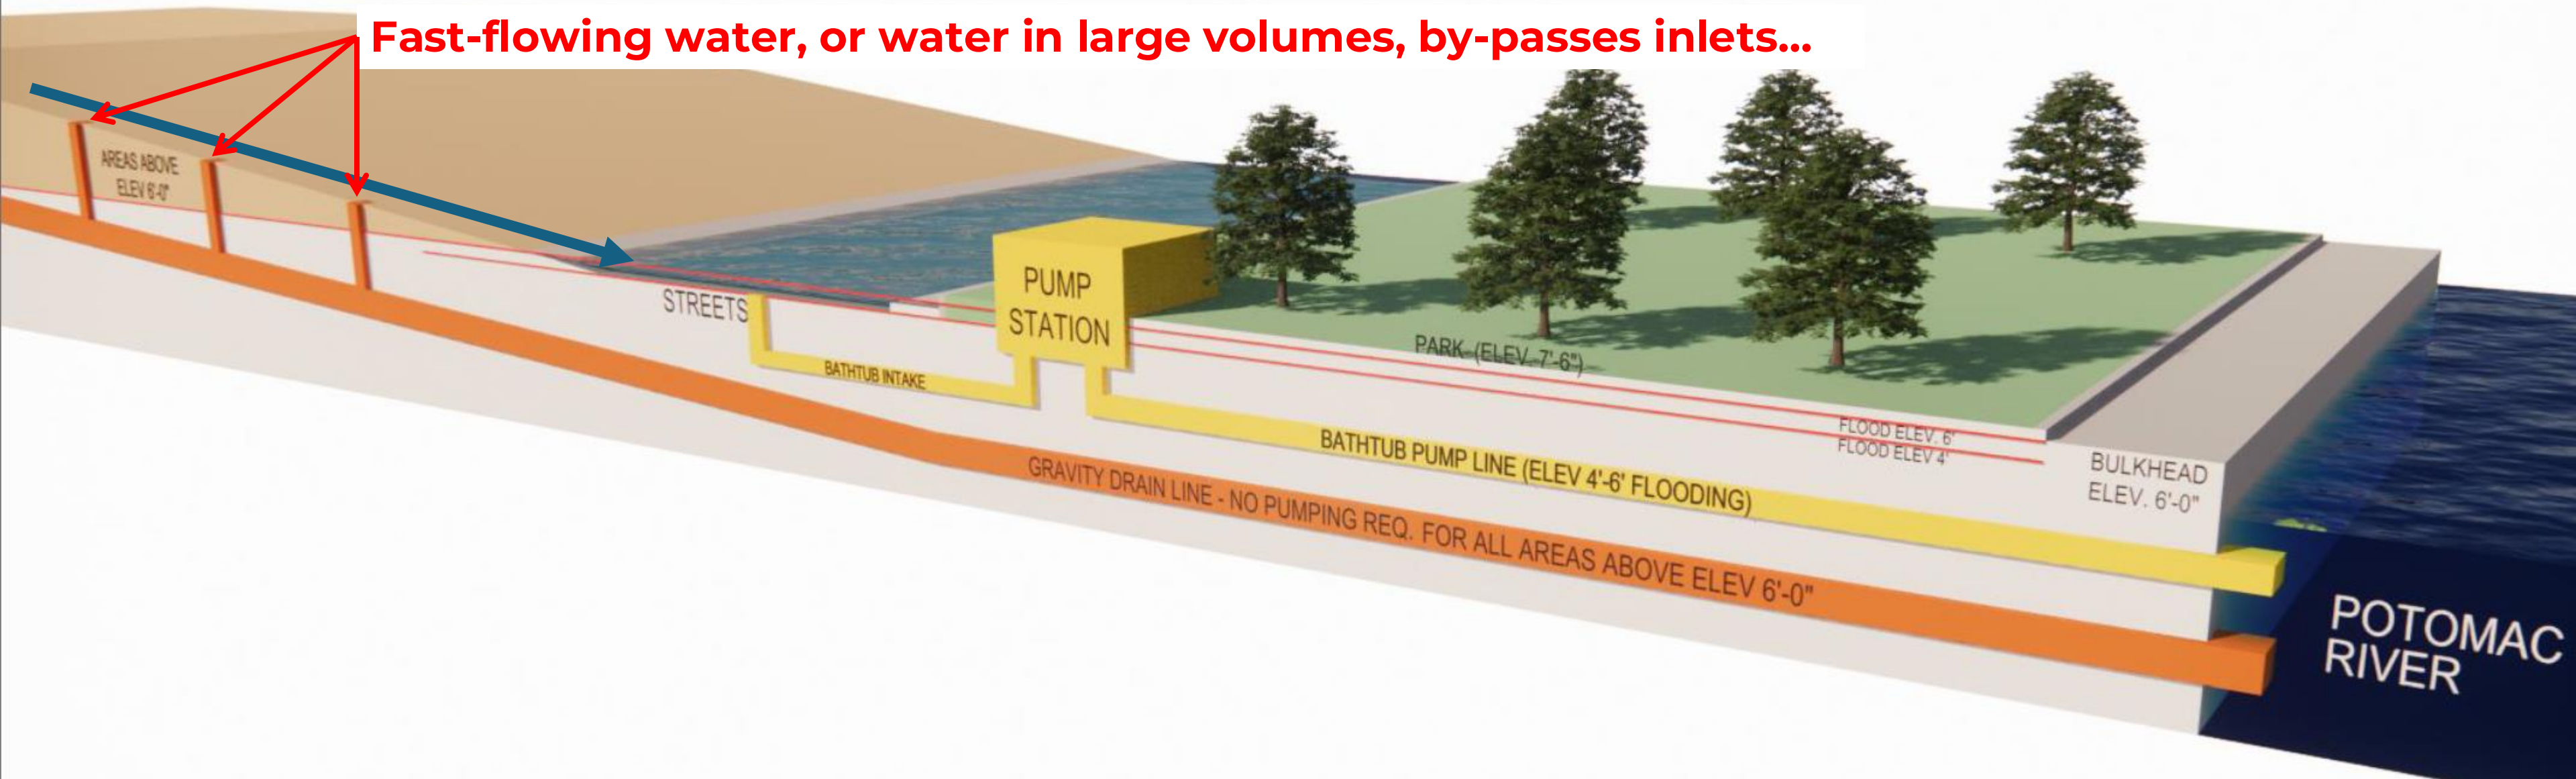

\*Underlying drawing credit: Mr. Paul Beckman, AIA 7/9/2025. Conceptual and not shown to scale. Additional markups by City of Alexandria.




# AWA Alternative Concept: Capacity Constraints

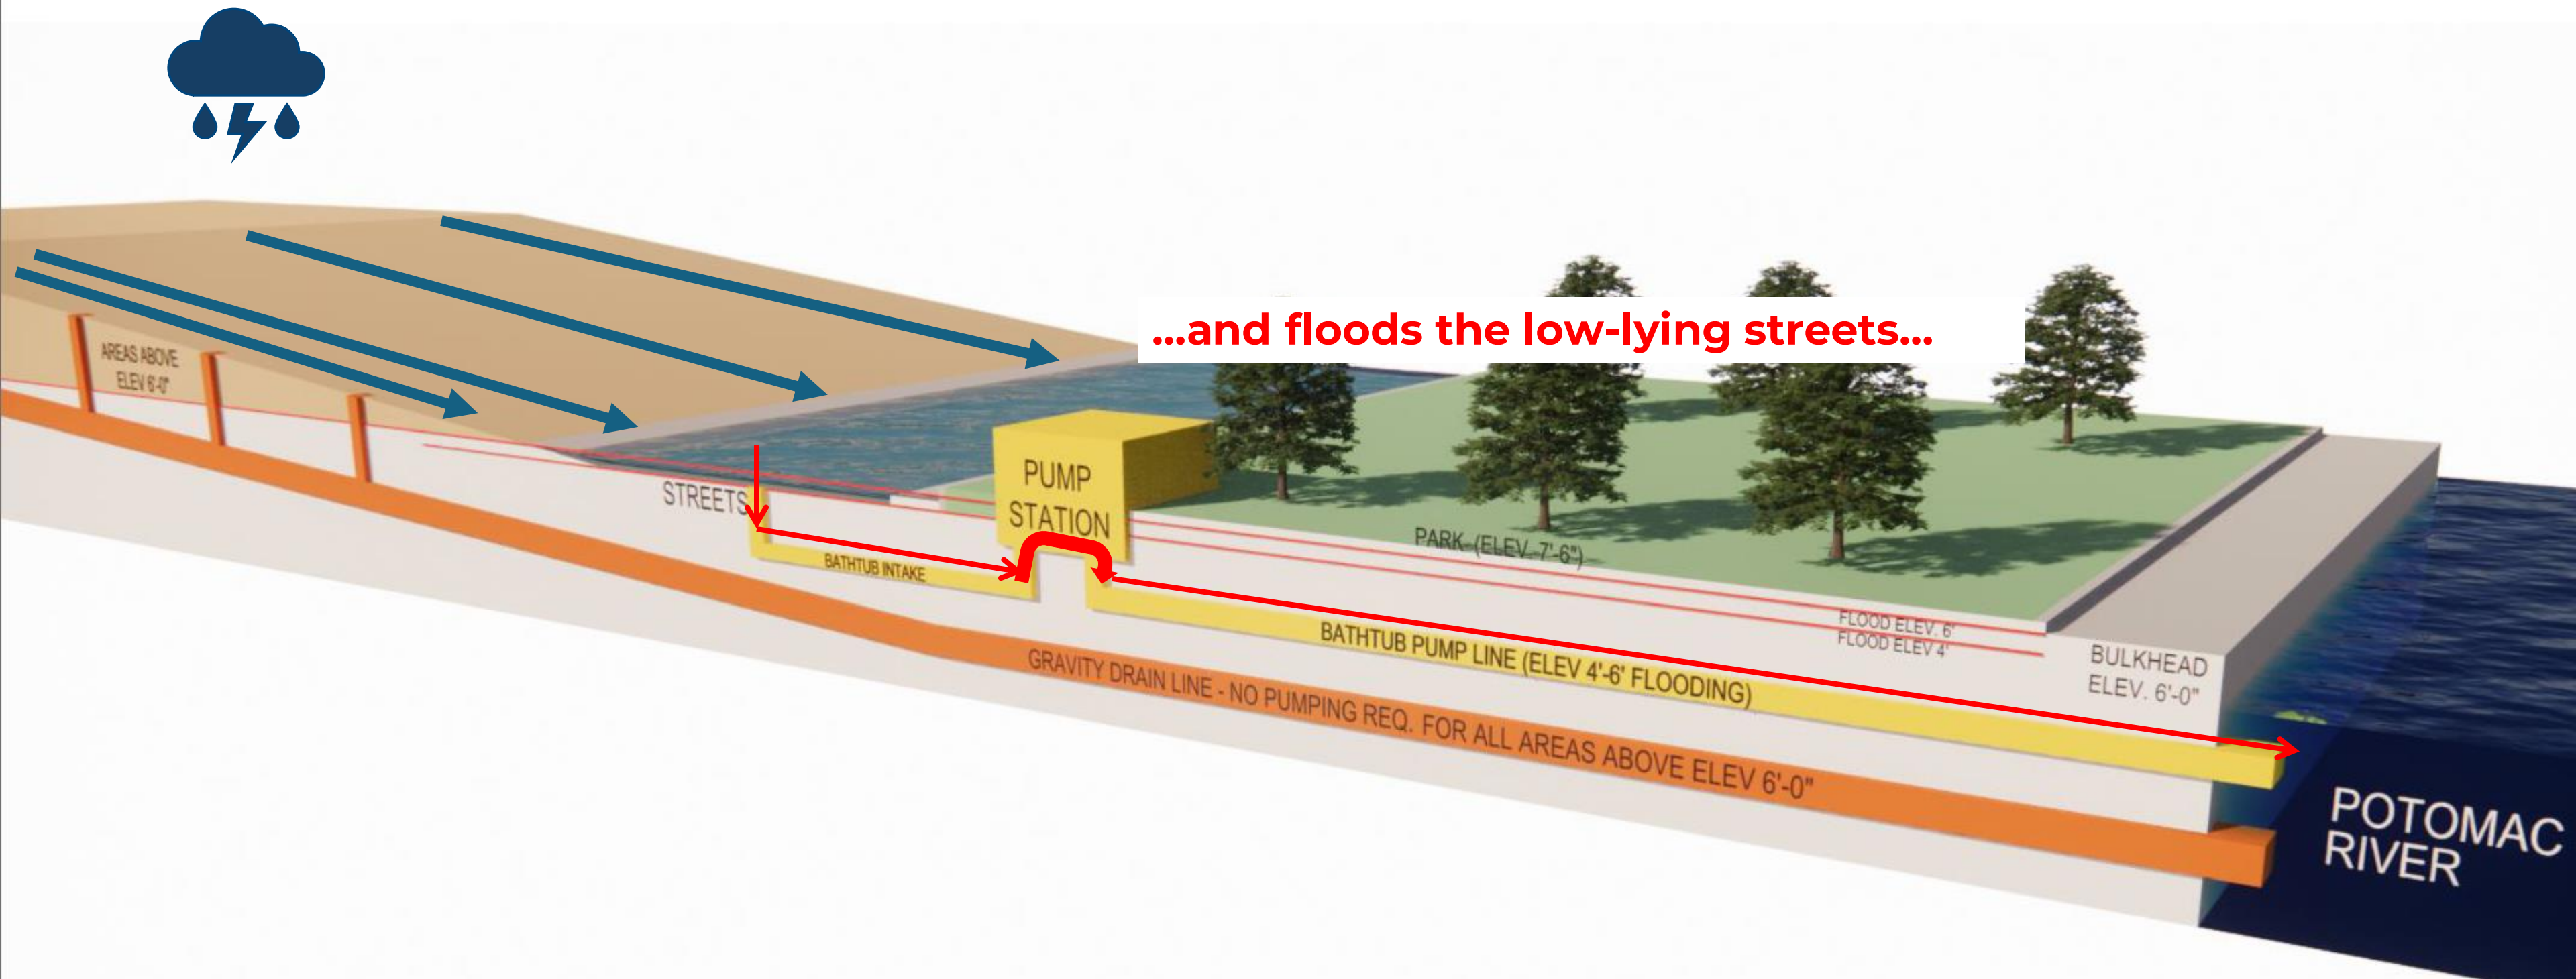

\*Underlying drawing credit: Mr. Paul Beckman, AIA 7/9/2025. Conceptual and not shown to scale. Additional markups by City of Alexandria.




# AWA Alternative Concept: Capacity Constraints

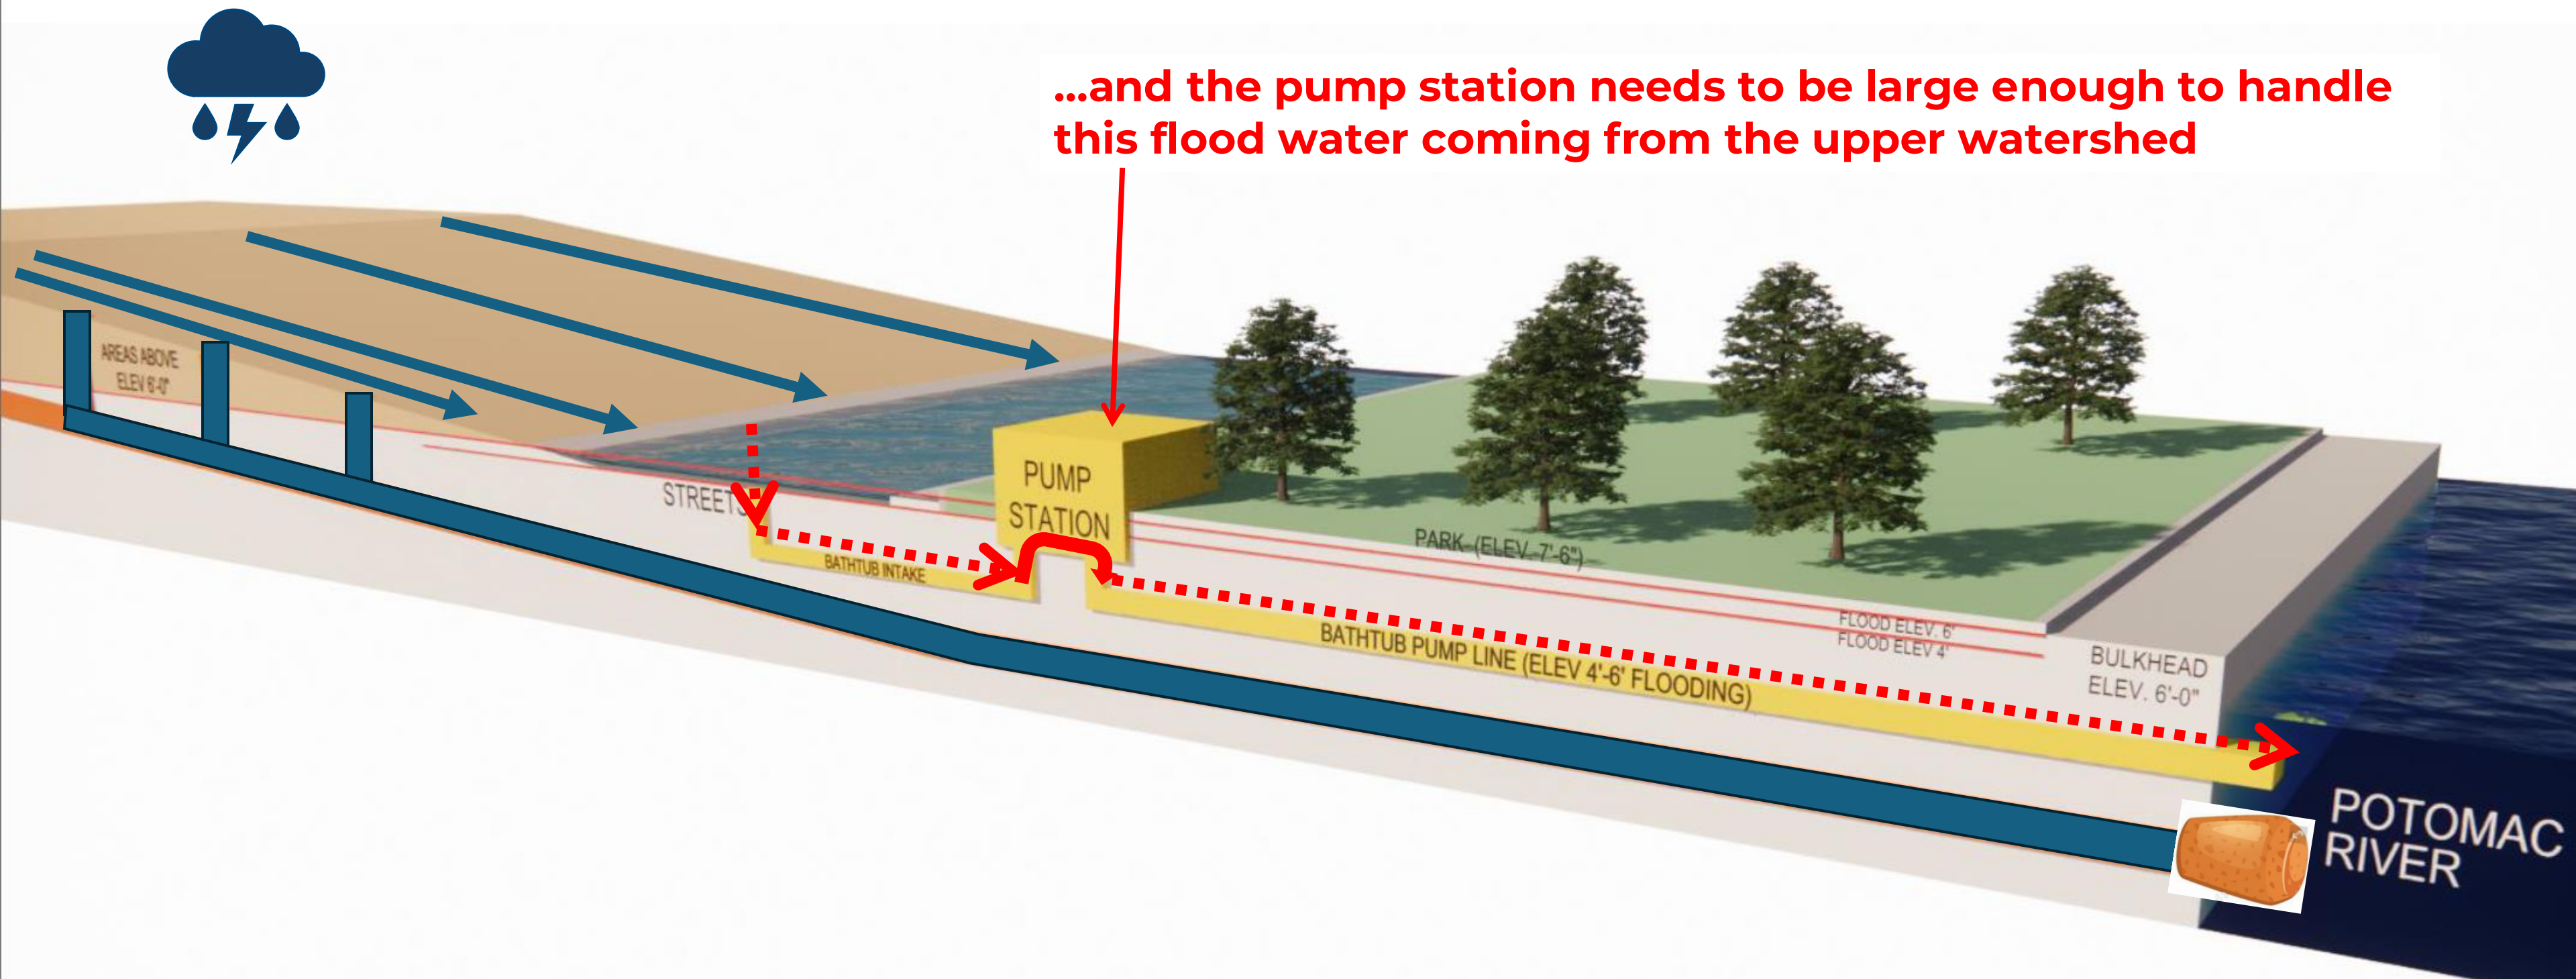



# AWA Alternative Concept: Gravity System & Tailwater Constraints

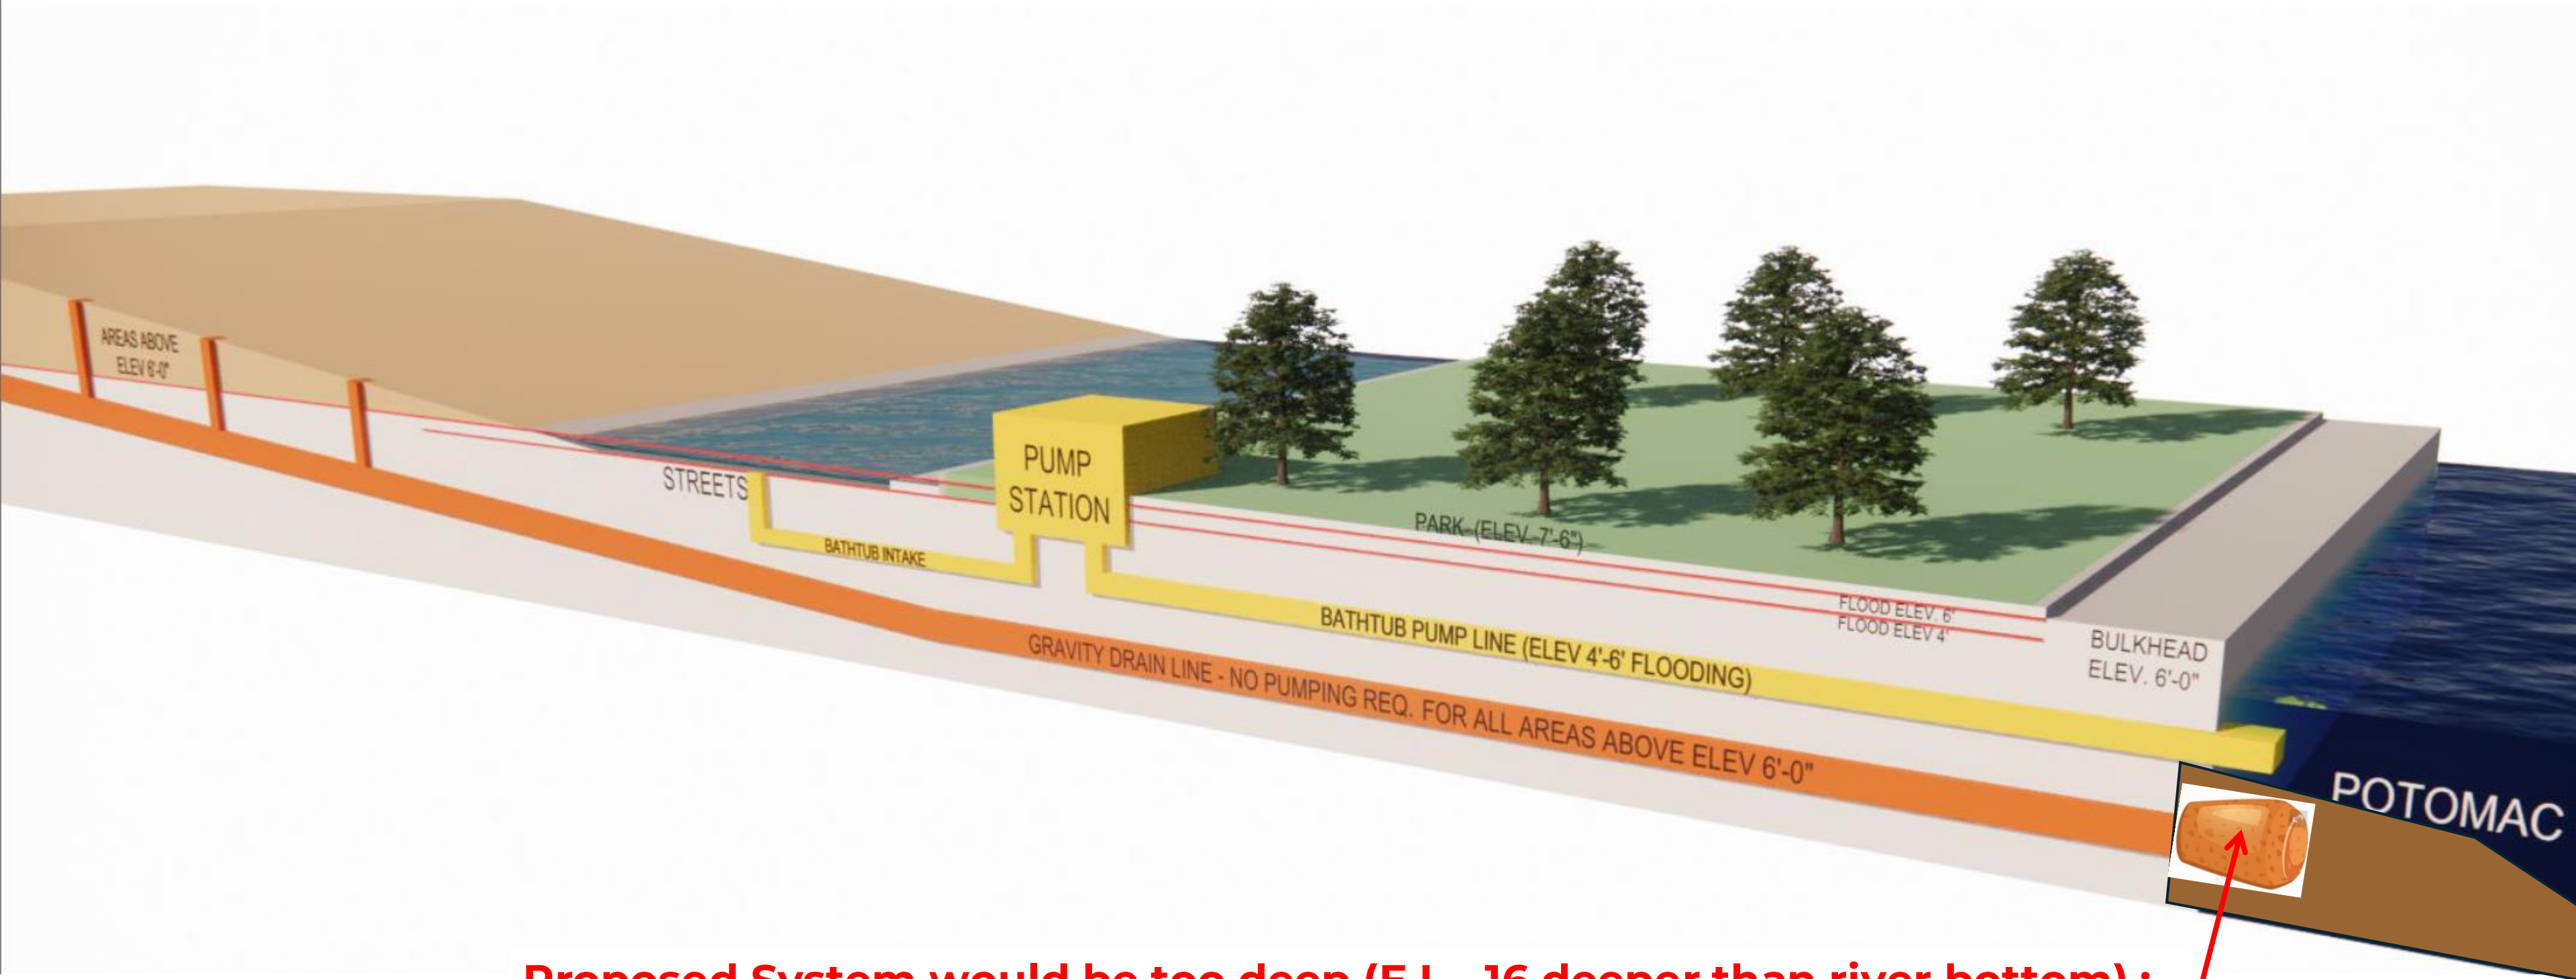


**Proposed System would be too deep (E.L. -16 deeper than river bottom):**  
**Force of Potomac River and mudline will act like a giant drain plug**



\*Underlying drawing credit: Mr. Paul Beckman, AIA 7/9/2025. Conceptual and not shown to scale. Additional markups by City of Alexandria.



# AWA Alternative Concept: Gravity System Depth Constraints

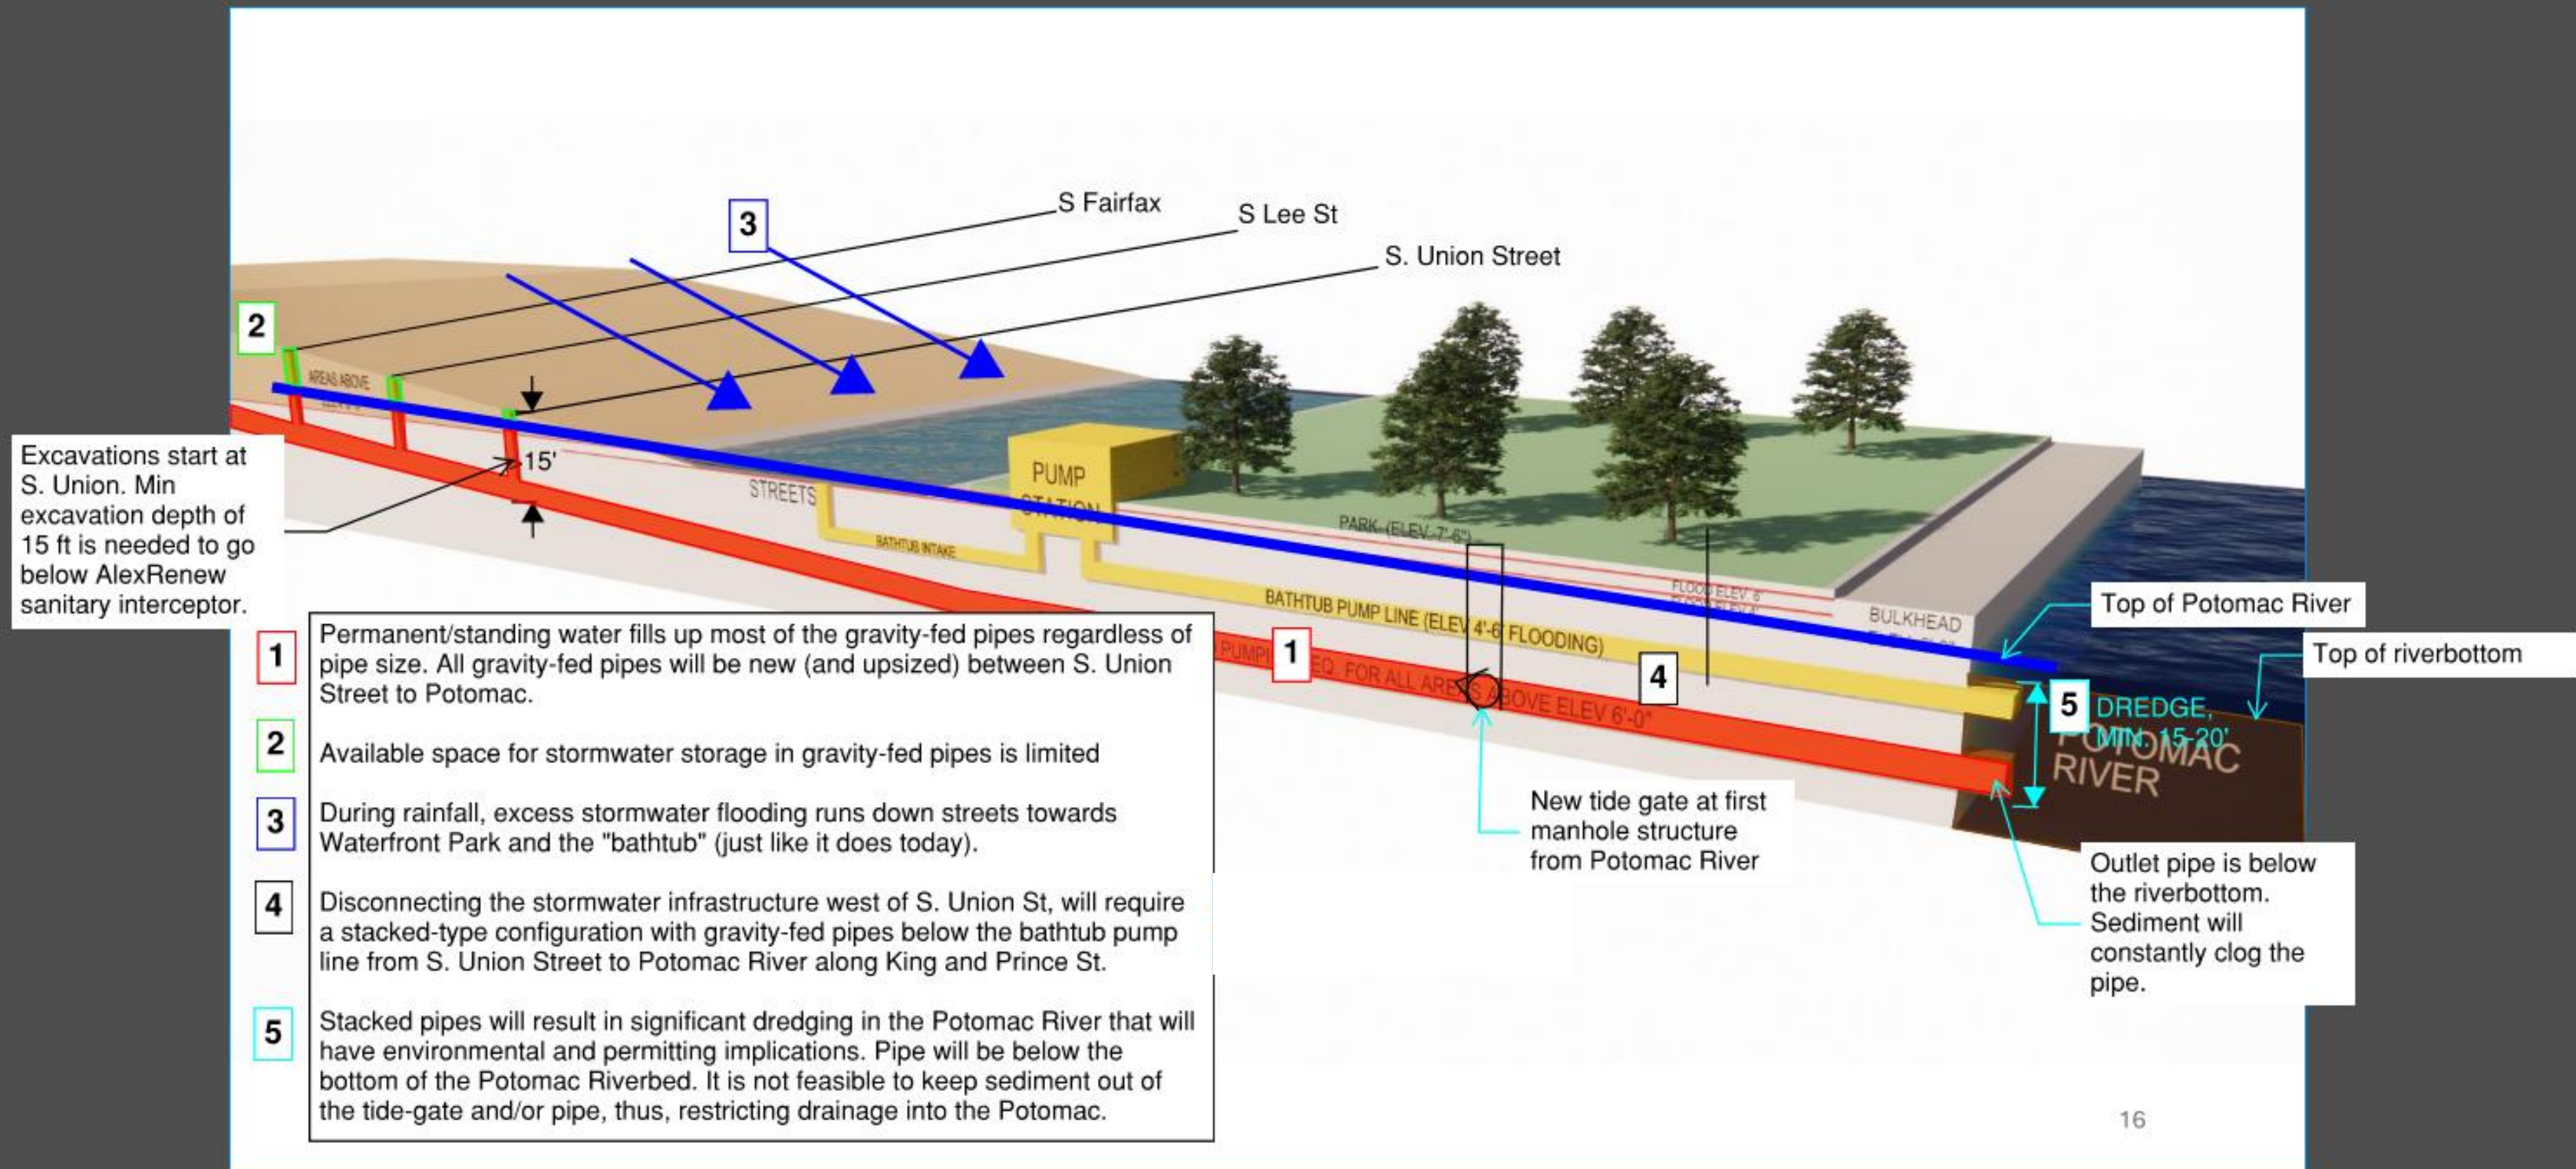




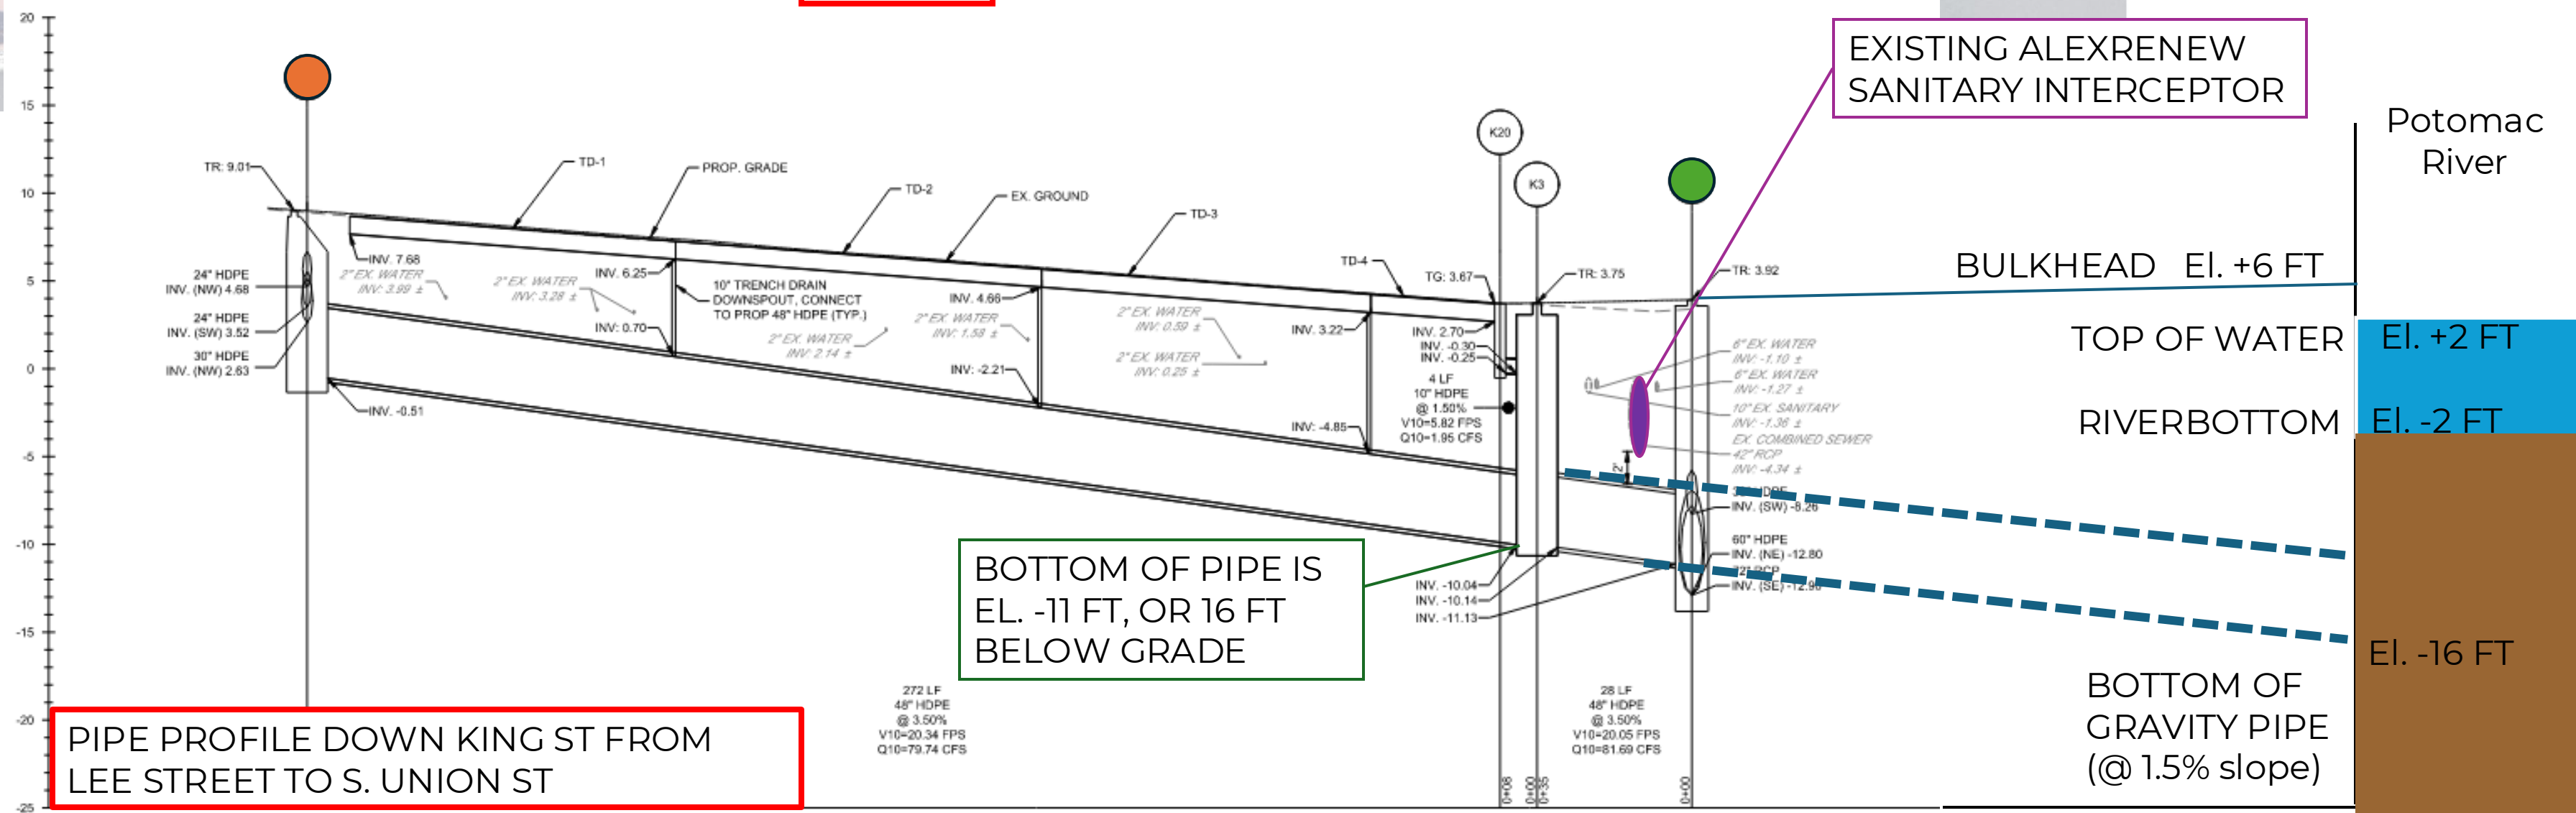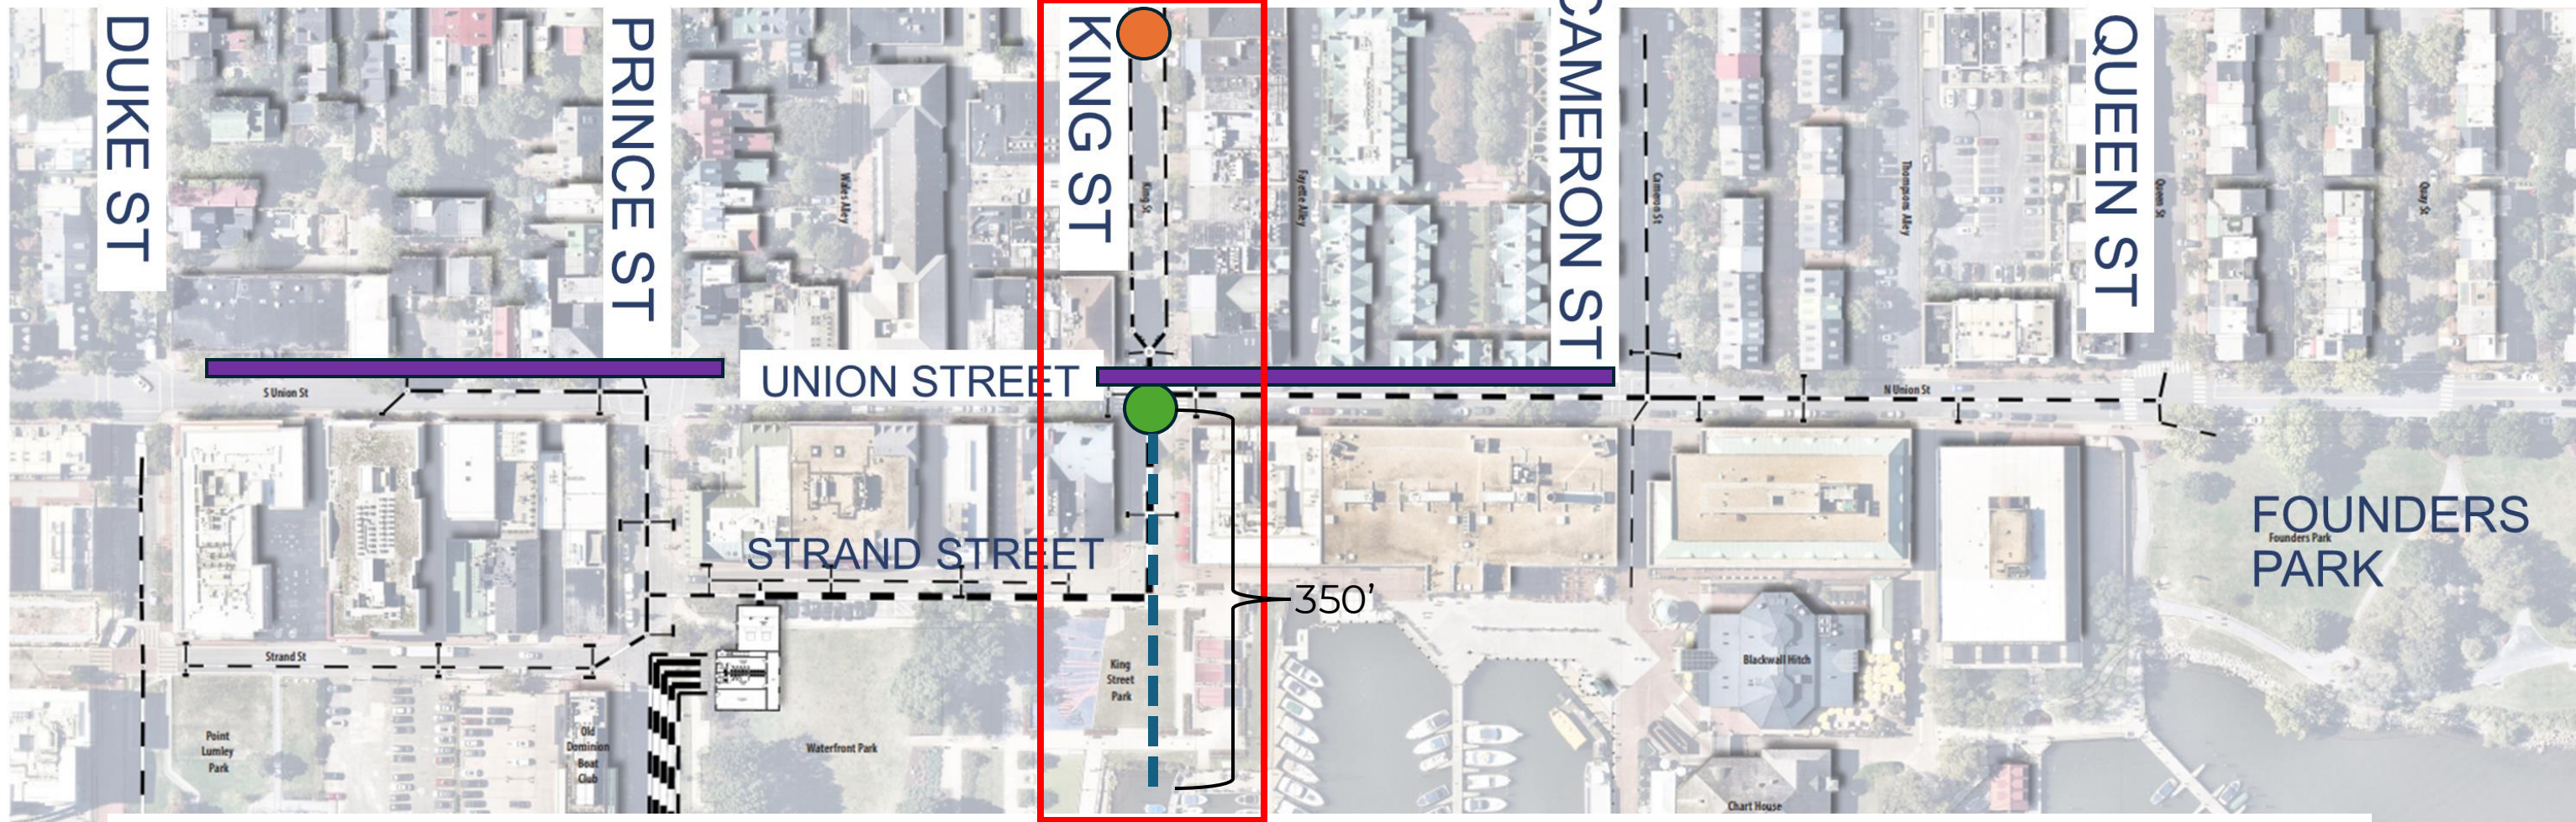




# AWA Alternative Concept: Gravity System & Tailwater Constraints

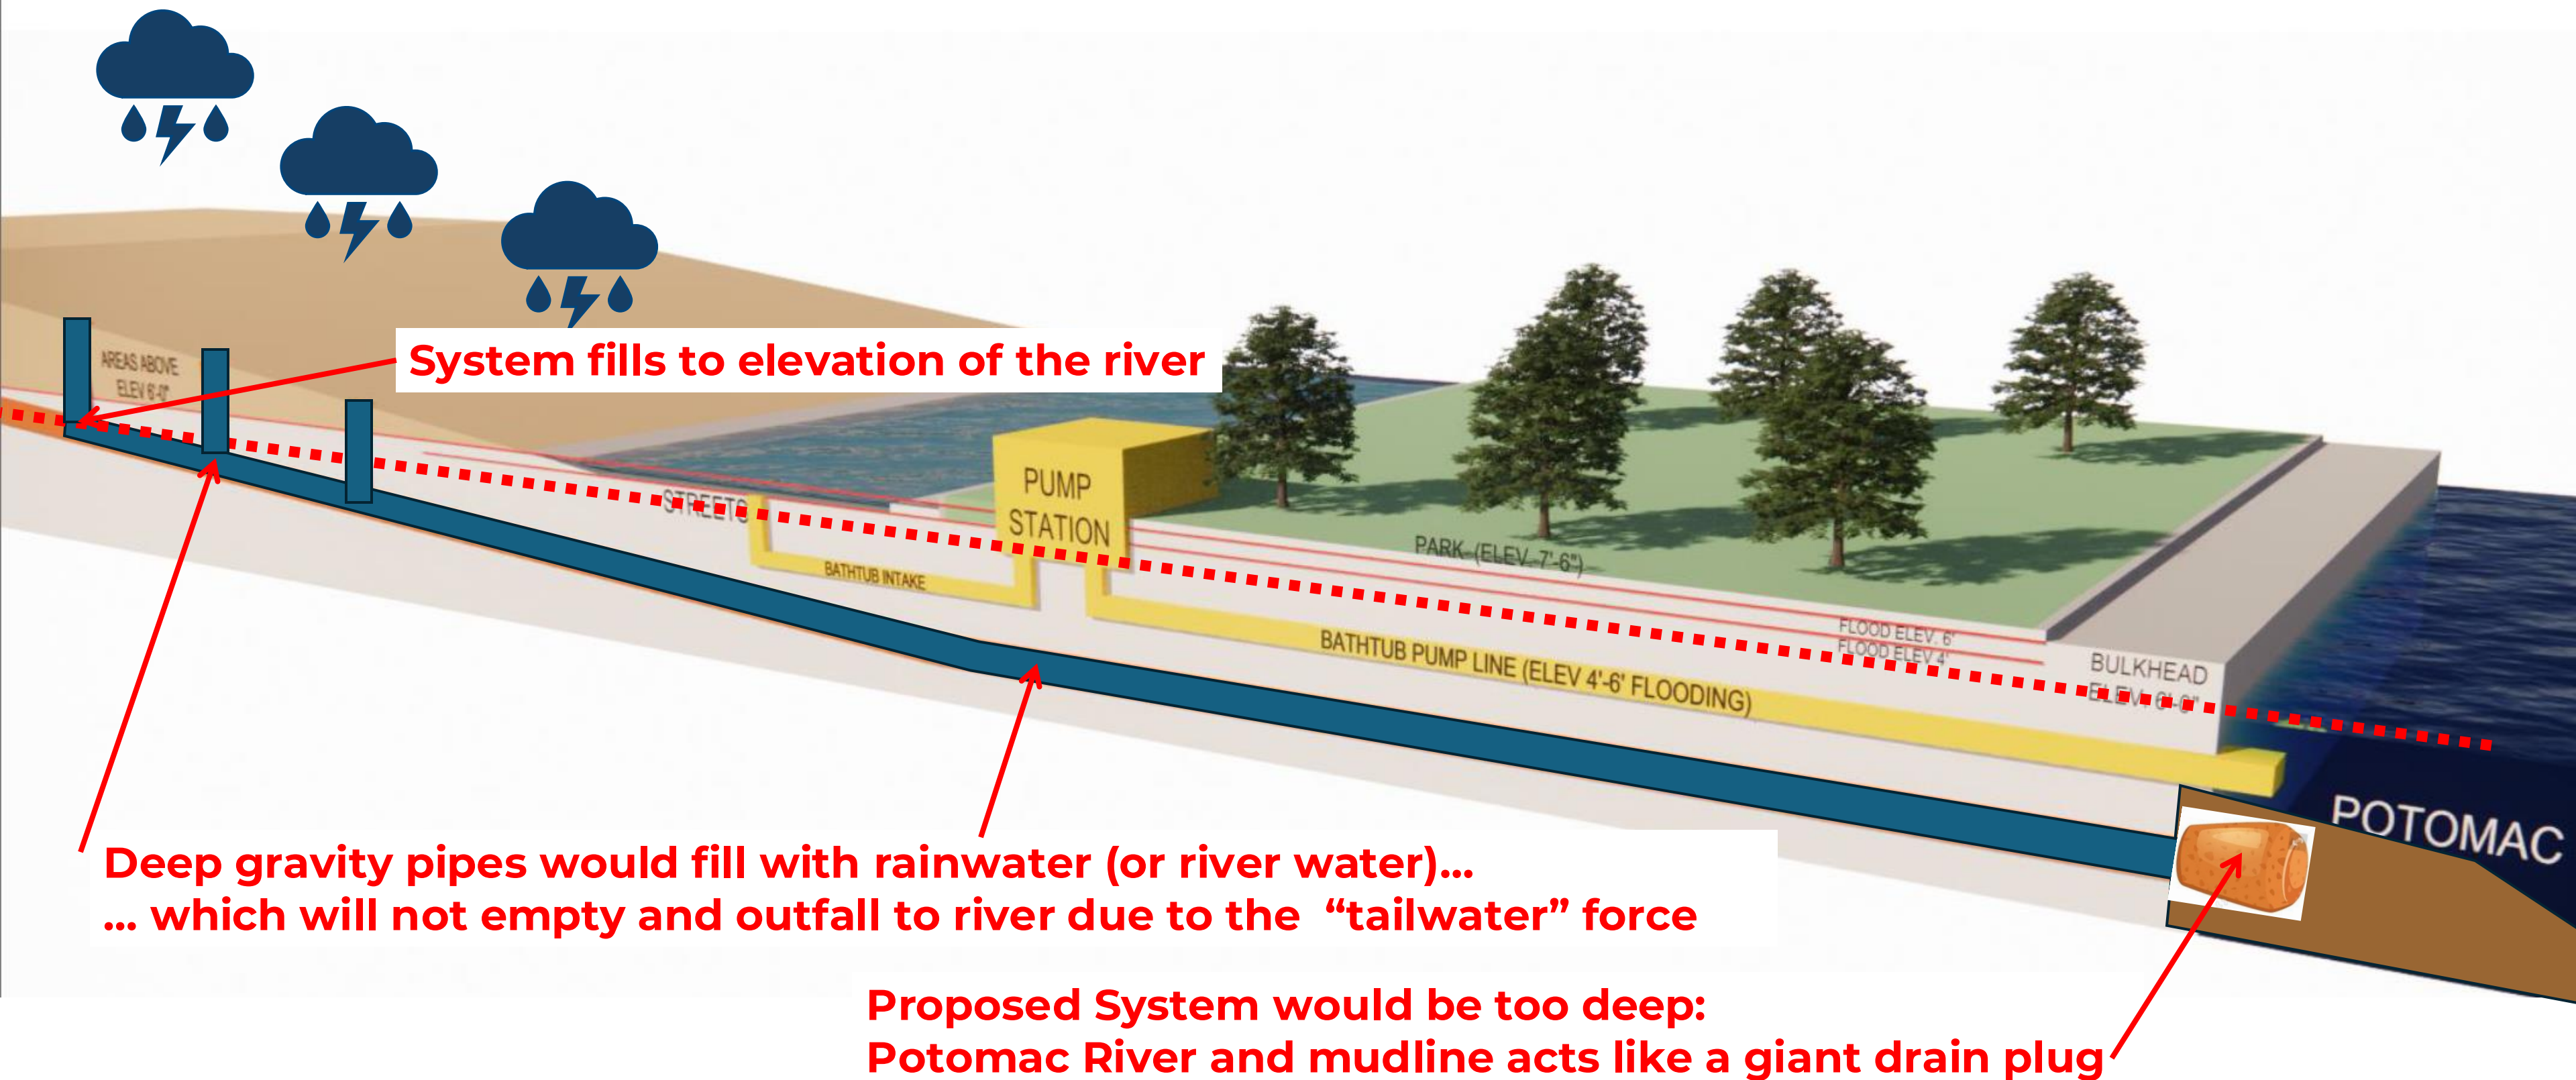

\*Underlying drawing credit: Mr. Paul Beckman, AIA 7/9/2025. Conceptual and not shown to scale. Additional markups by City of Alexandria.




# AWA Alternative Concept: Gravity System & Tailwater Constraints

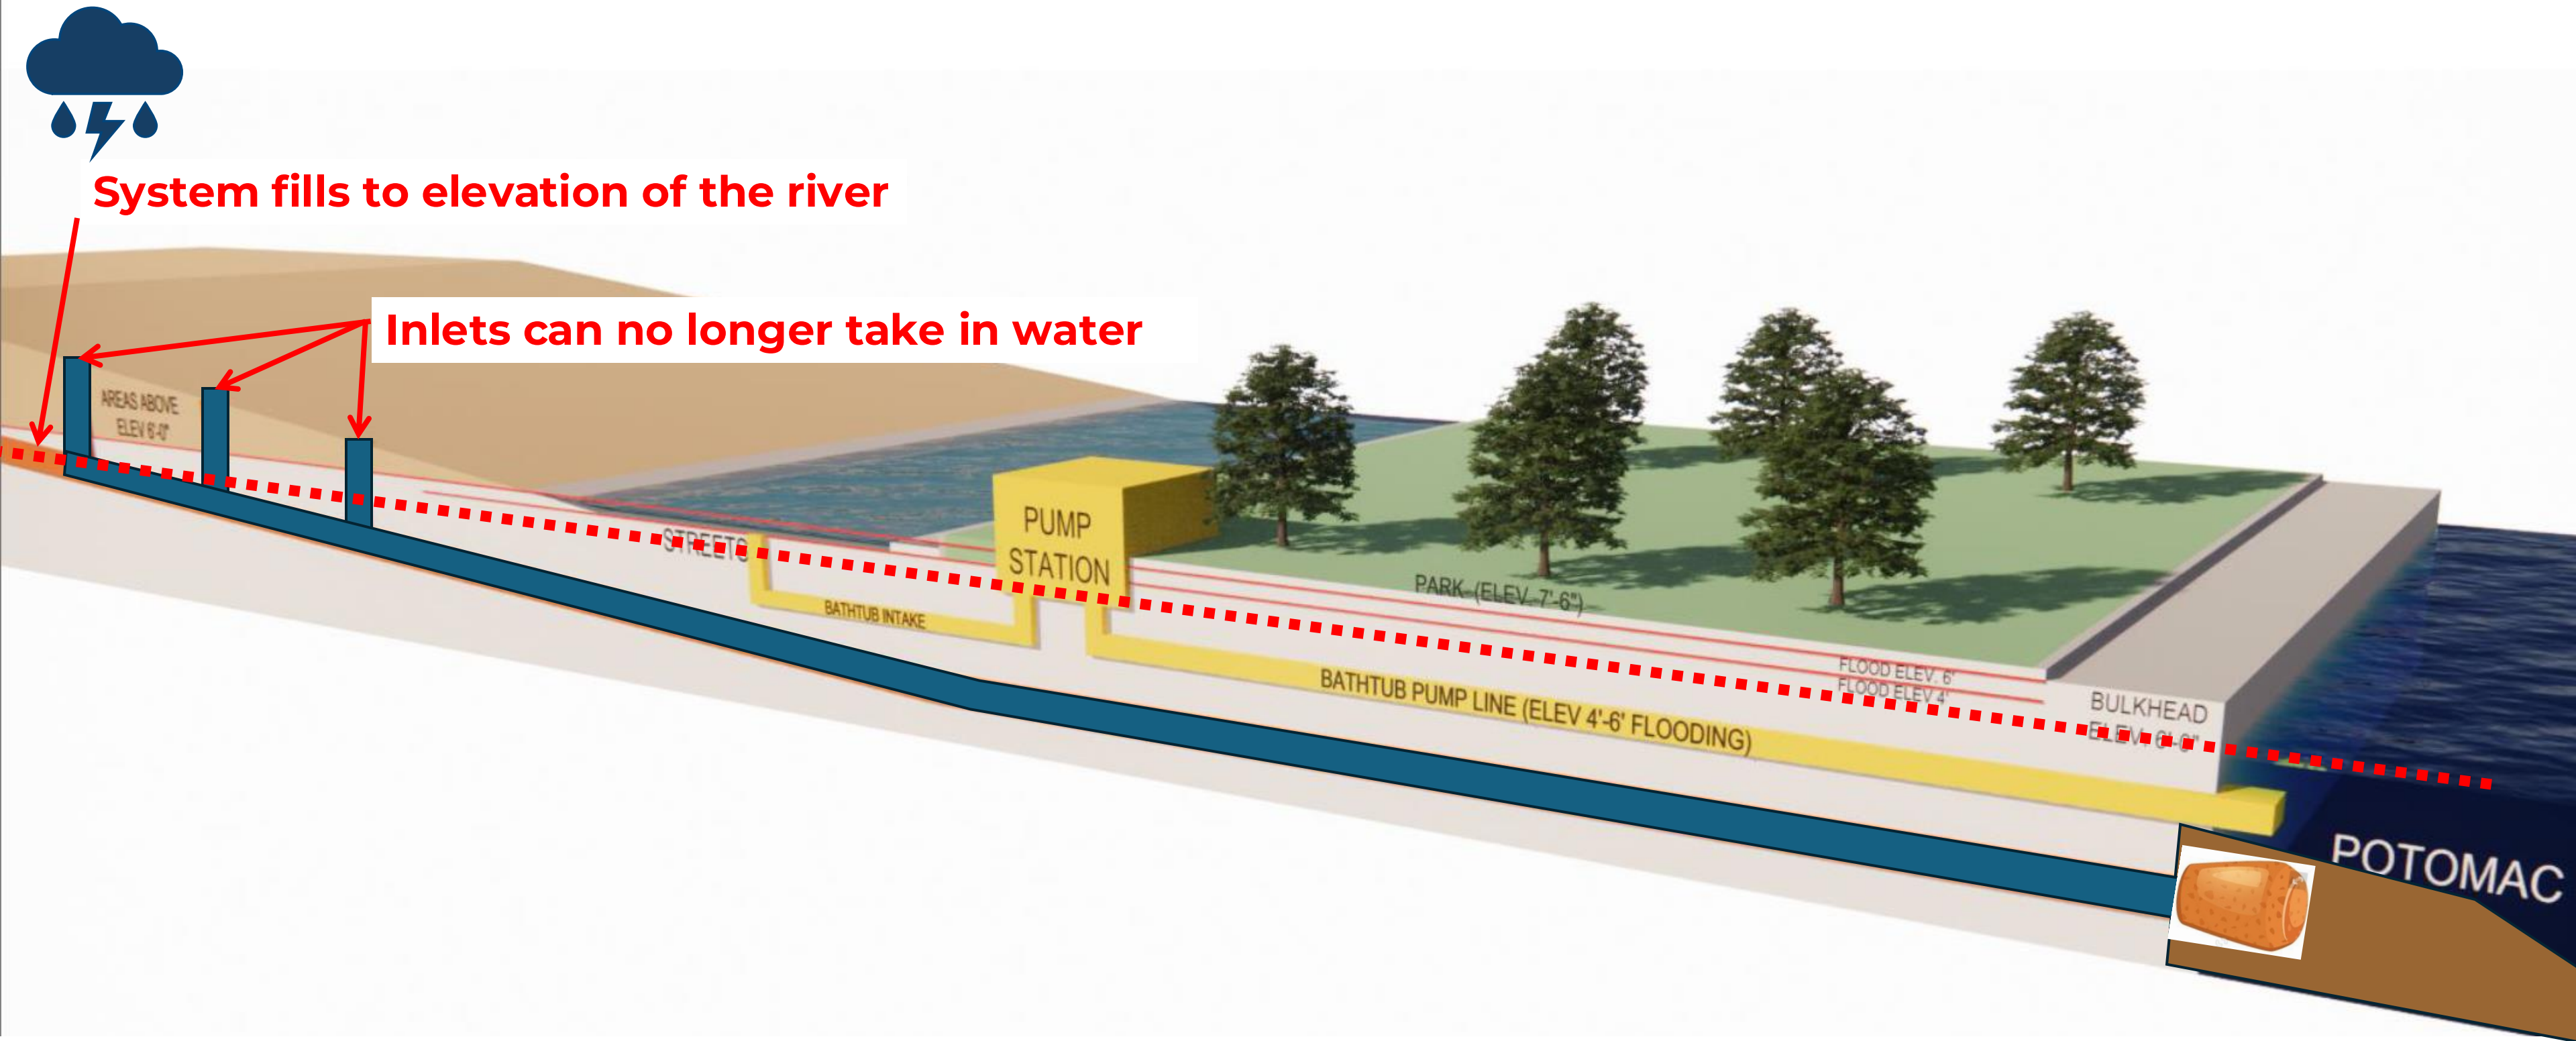

\*Underlying drawing credit: Mr. Paul Beckman, AIA 7/9/2025. Conceptual and not shown to scale. Additional markups by City of Alexandria.




# AWA Alternative Concept: Gravity System & Tailwater Constraints

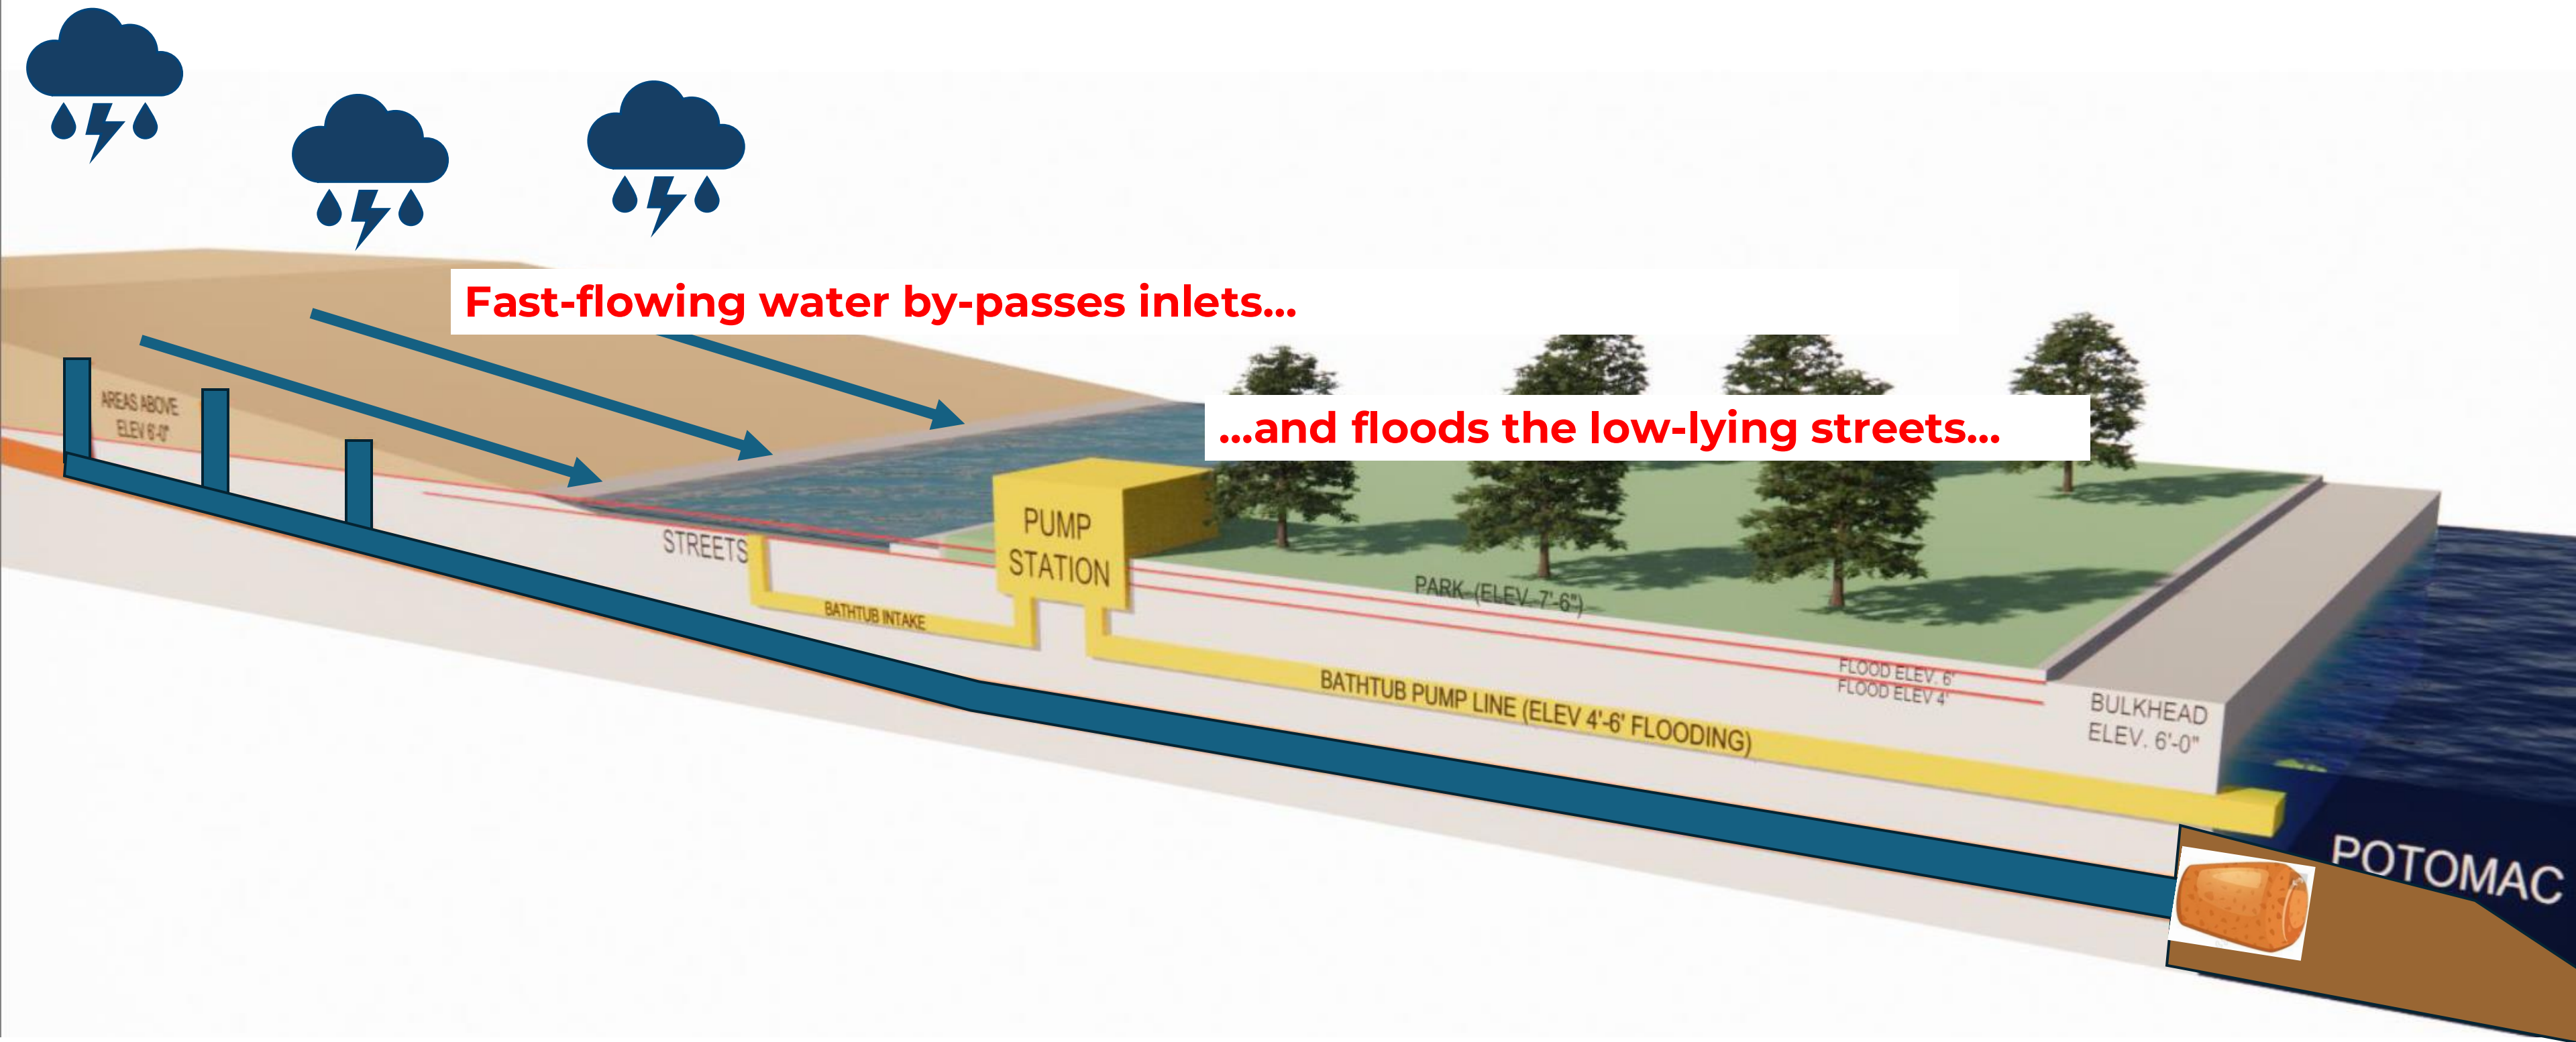

\*Underlying drawing credit: Mr. Paul Beckman, AIA 7/9/2025. Conceptual and not shown to scale. Additional markups by City of Alexandria.




# AWA Alternative Concept: Gravity System & Tailwater Constraints

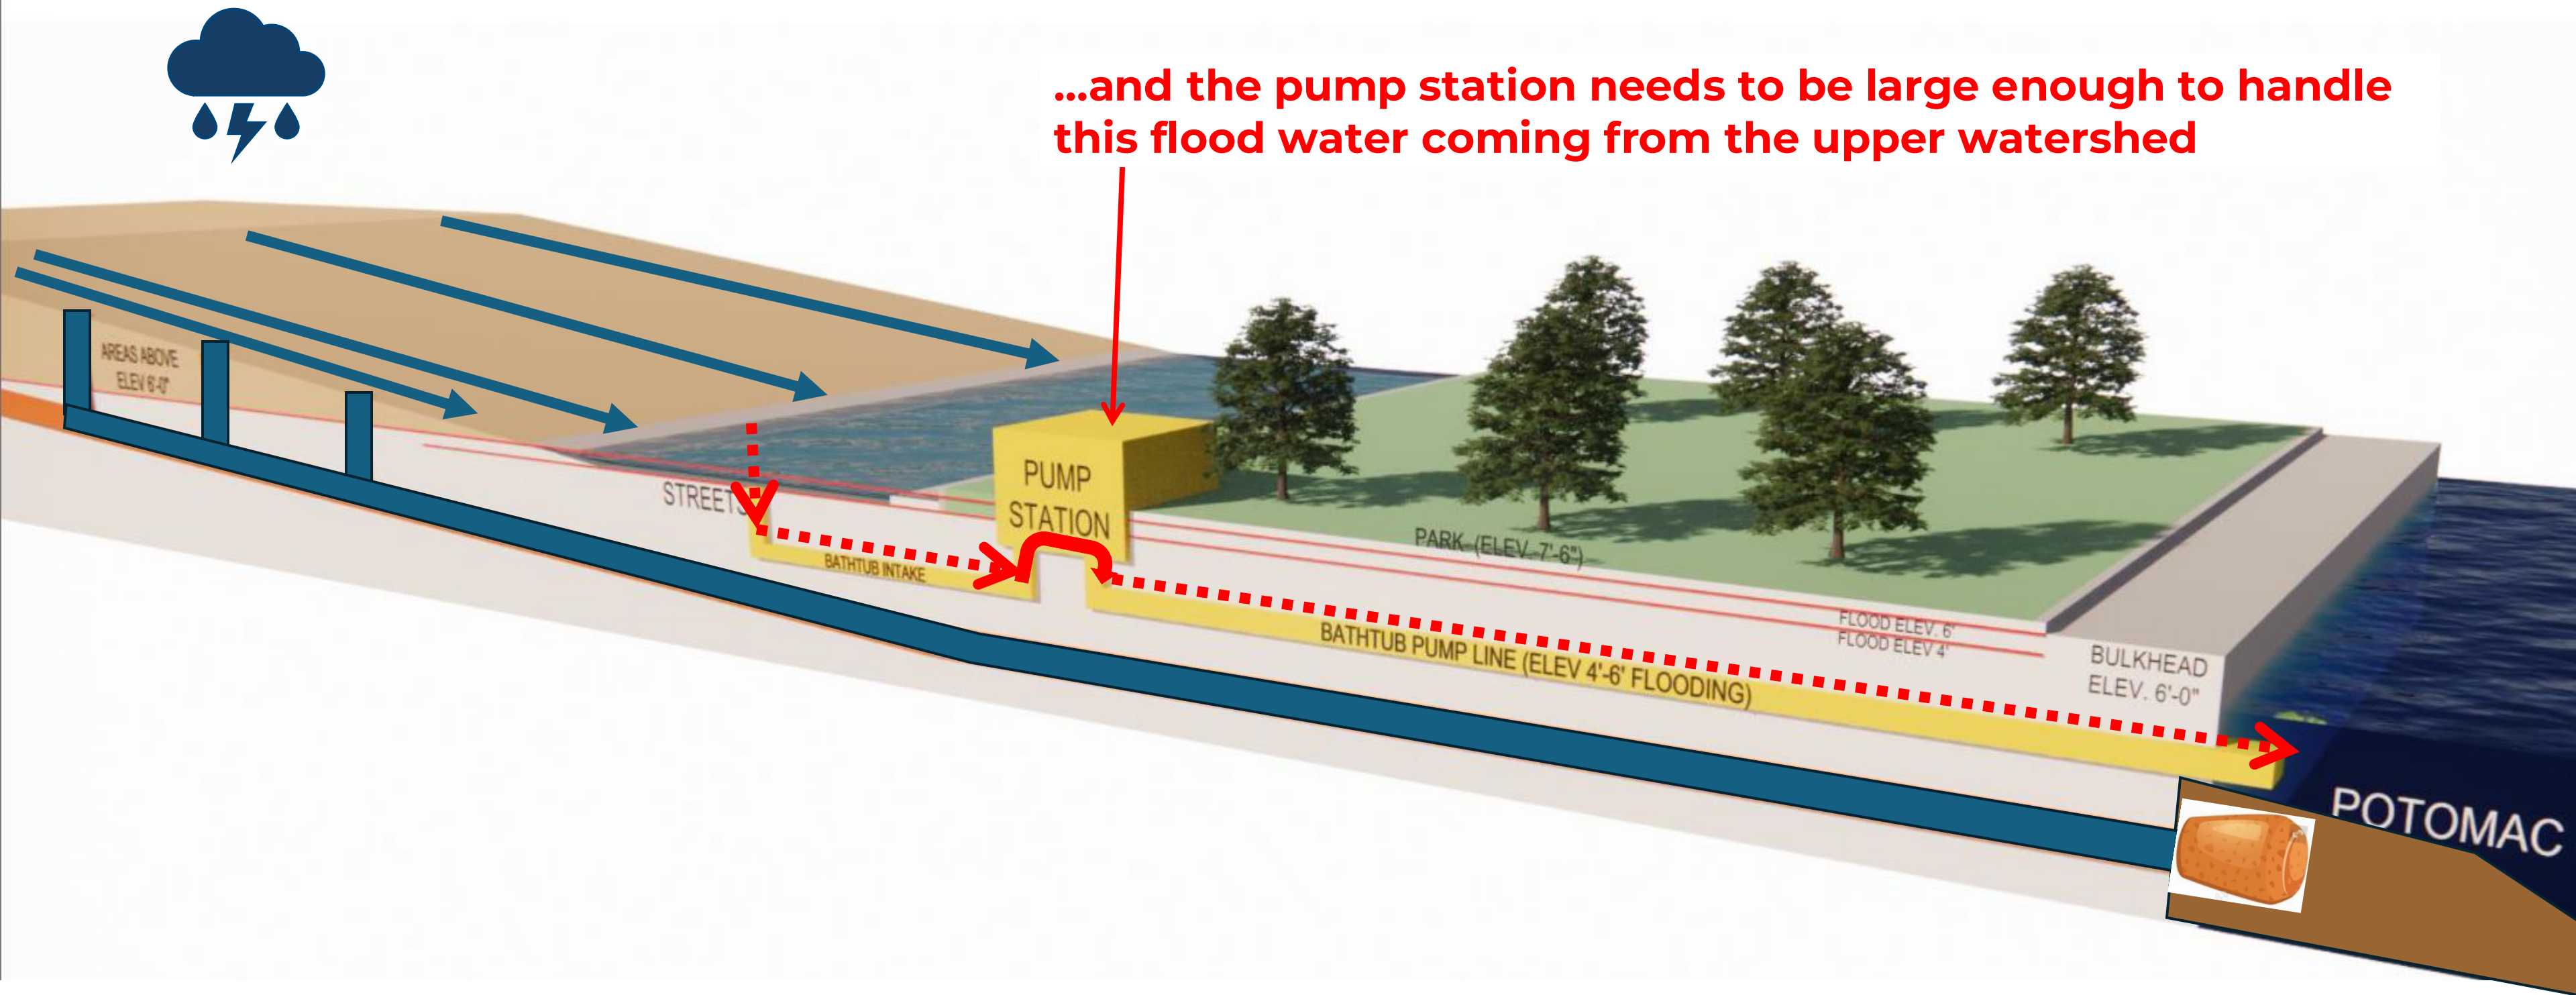




# AWA Alternative Concept: Gravity System & Tailwater Constraints

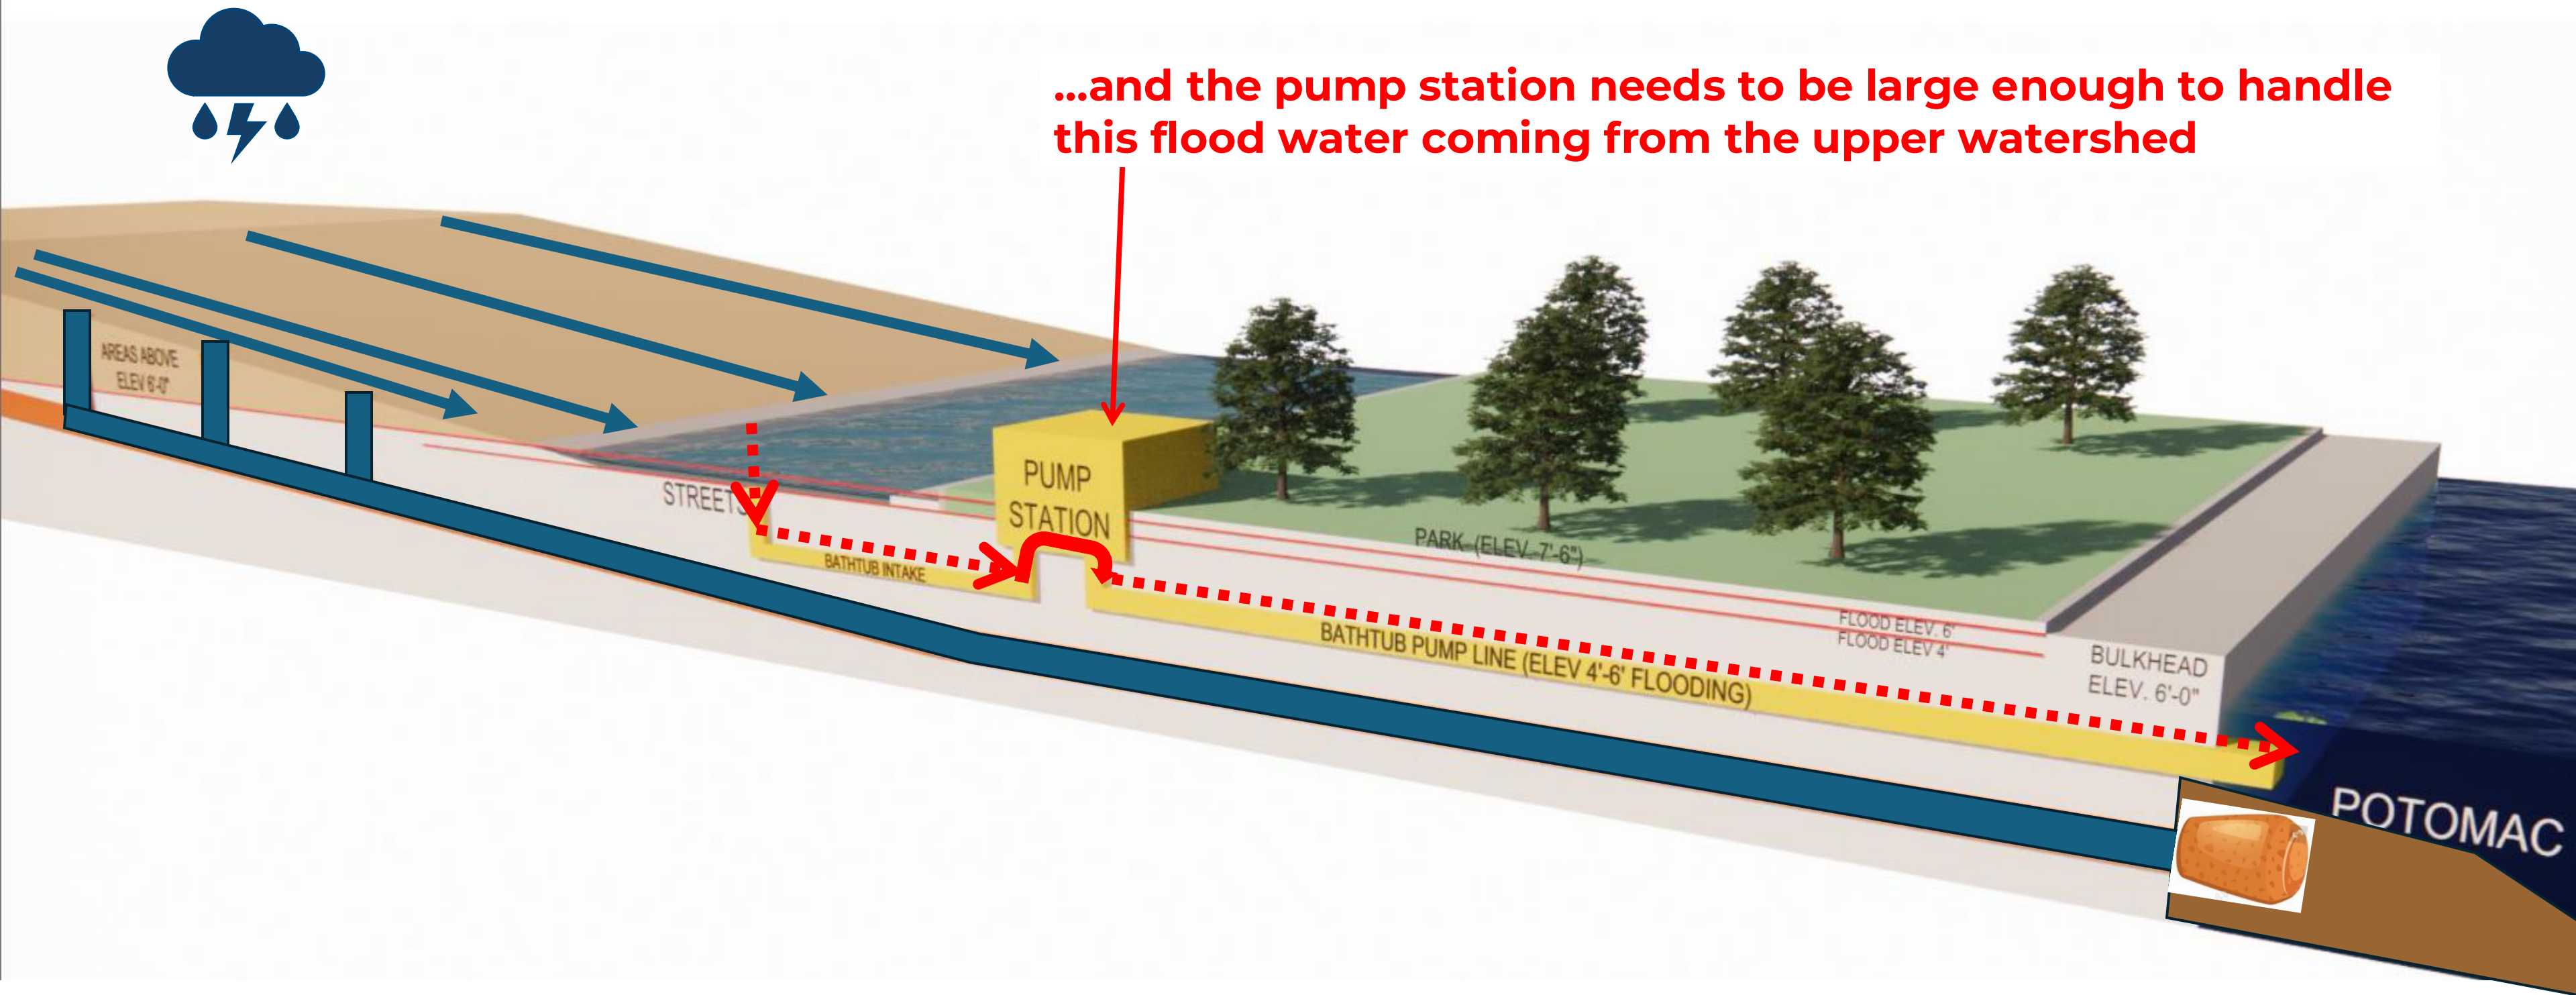



# AWA Alternative Concept: Gravity System & Tailwater Constraints

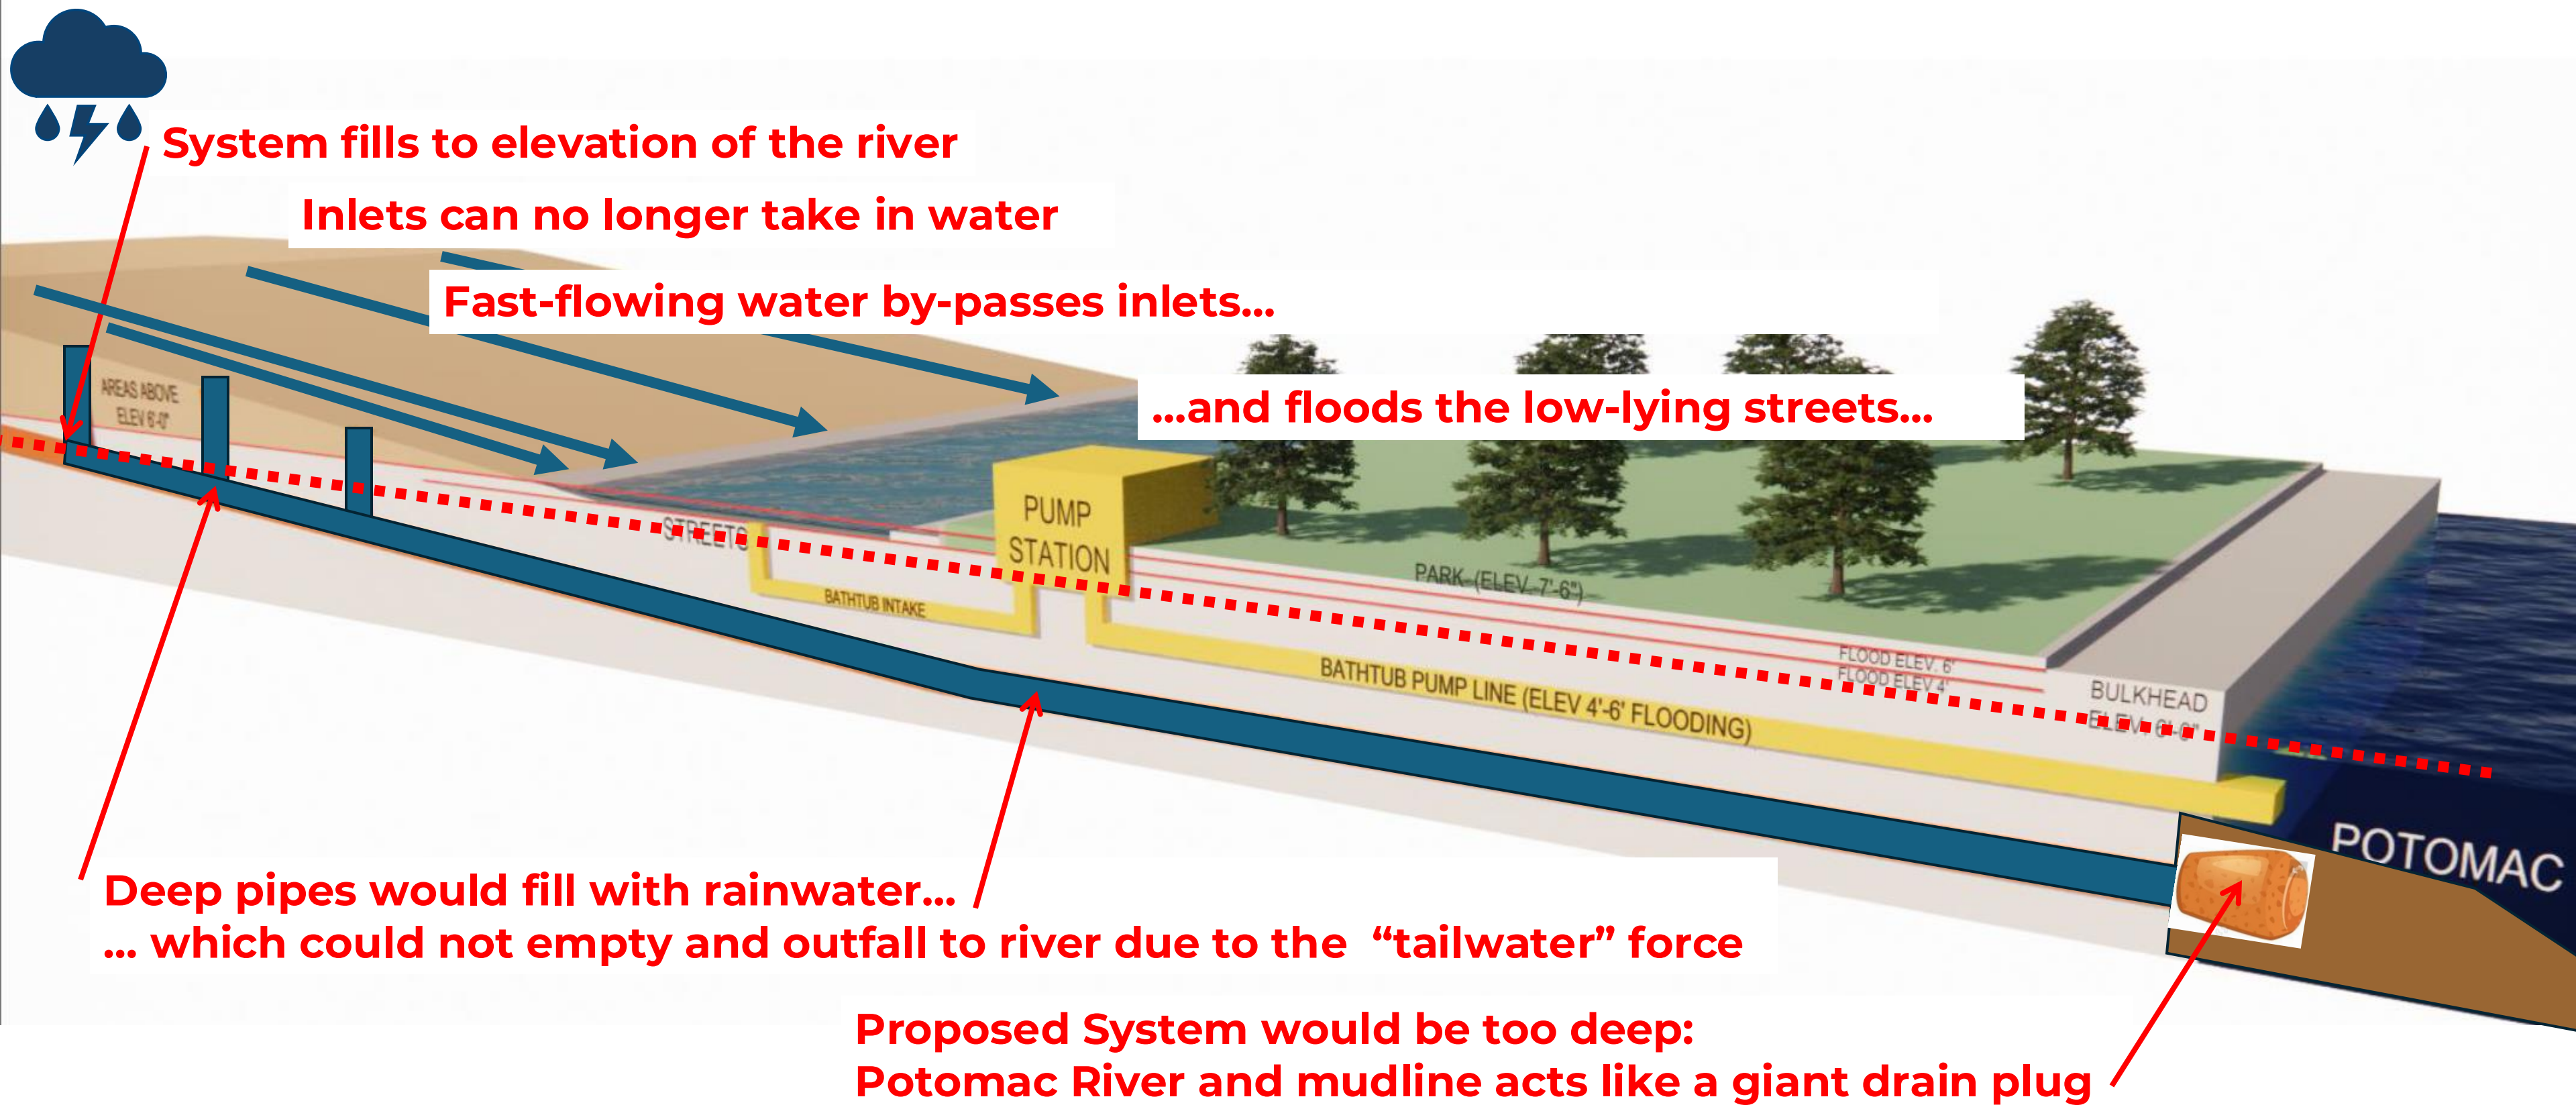

\*Underlying drawing credit: Mr. Paul Beckman, AIA 7/9/2025. Conceptual and not shown to scale. Additional markups by City of Alexandria.





# Stormwater Modeling Results: “85% Solution” Concept

Gravity Stormwater System, Backflow Prevention  
& Capacity Improvements North of King St



# AWA Concept - Flooding at the Storm Peak

This concept fails to prevent 1 - 1.5 feet of flooding



## Key Results




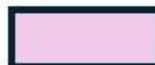

- Potential damage to buildings and cars, including parking garages, residences, and businesses.
  - N Union from Thompsons Alley to Cameron Street
  - Unit Block of Thompsons Alley
- Impacts may include the basement, first floor, or building access.
- Sidewalks and roadways are passible and drivable in less than 30 minutes.






## Alexandria Waterfront Alliance

### Flood Mitigation Alternatives 7/3/25

1. Replace exist. outdated storm sewers and drain directly to the river 
2. Deployable flood barrier at N Union 
3. Elevate bathtub streetscape to 4' where possible & drain to pump 
4. Reocated pump station 
5. Delete proposed new Union St. pipes 

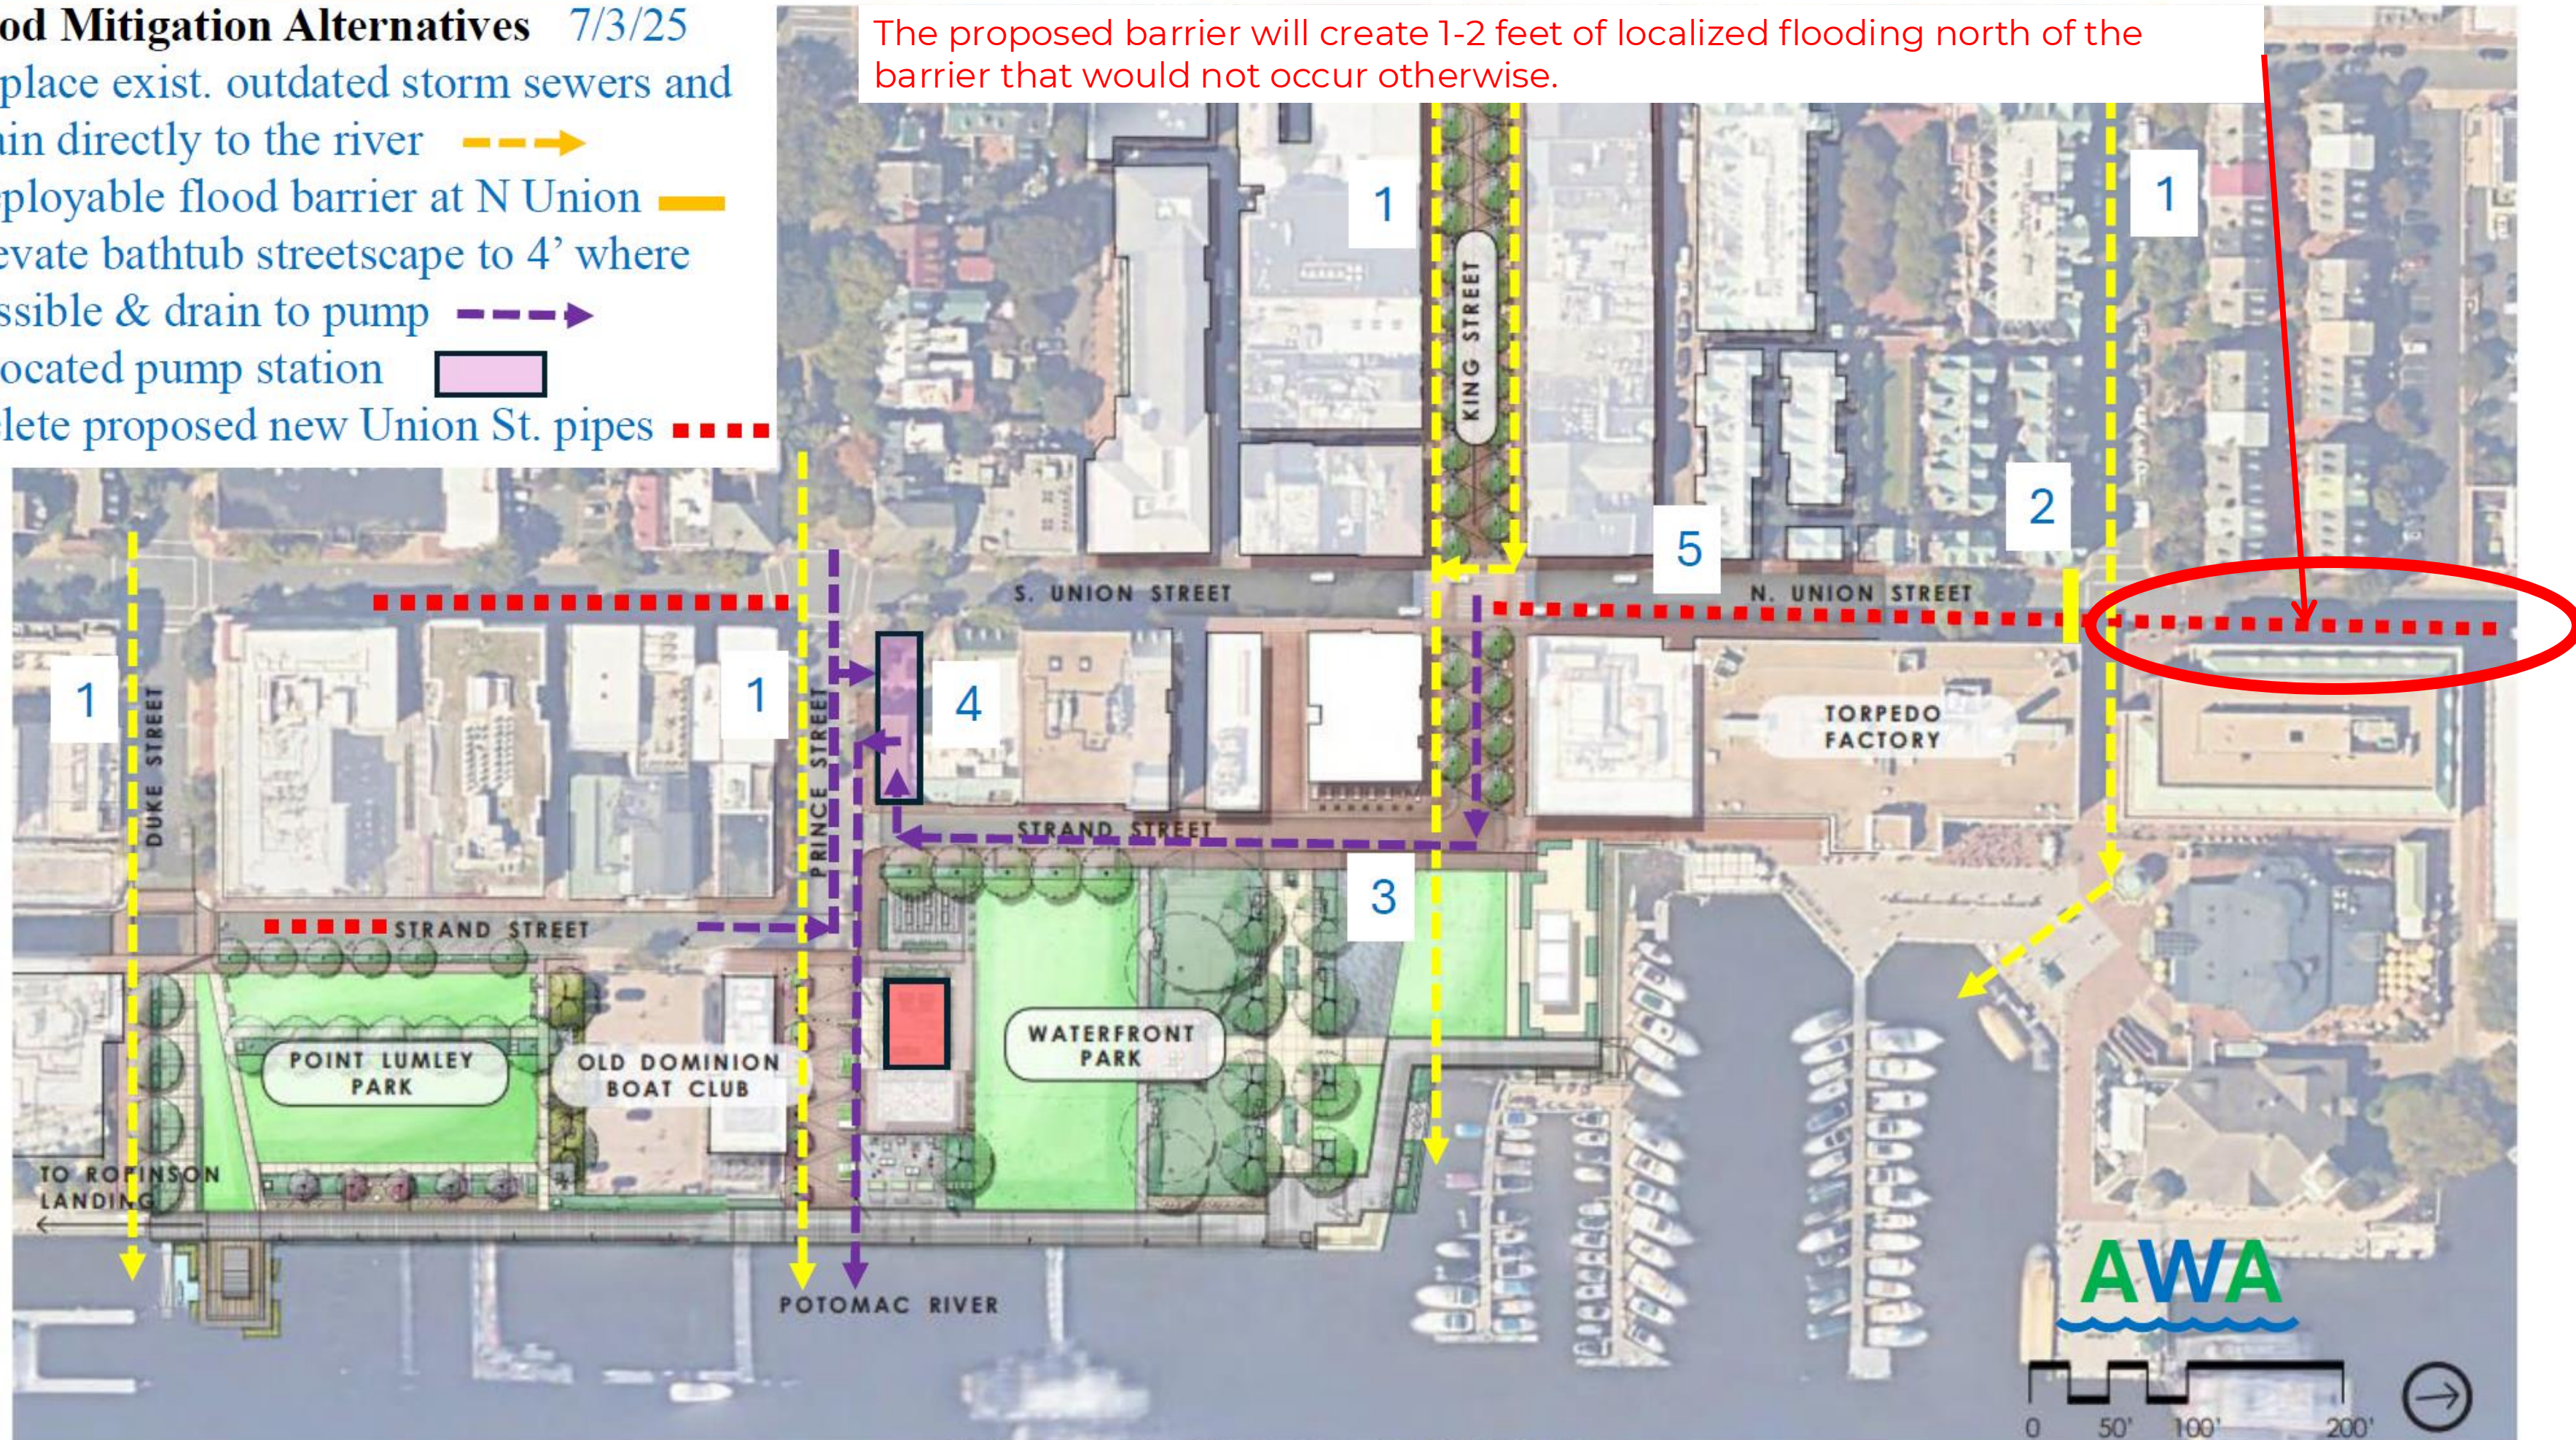

OVERALL PROJECT CONCEPT PLAN



## Alexandria Waterfront Alliance

### Flood Mitigation Alternatives 7/3/25


1. Replace exist. outdated storm sewers and drain directly to the river ---➔
2. Deployable flood barrier at N Union —
3. Elevate bathtub streetscape to 4' where possible & drain to pump ---➔
4. Reocated pump station
5. Delete proposed new Union St. pipes ---

A deployable pump can be further evaluated for this location; however, it won't reduce the pump station size.

Potential that manhole at Cameron/Union intersection could be used as a point for bypass pumping.

Would require further analysis of capacity of a trailer-mounted bypass pump on Union St. Potential route for discharge hose to the Potomac River shown.

The bypass pump would need to be sized to handle the floodwater that accumulates behind any the deployable barrier.

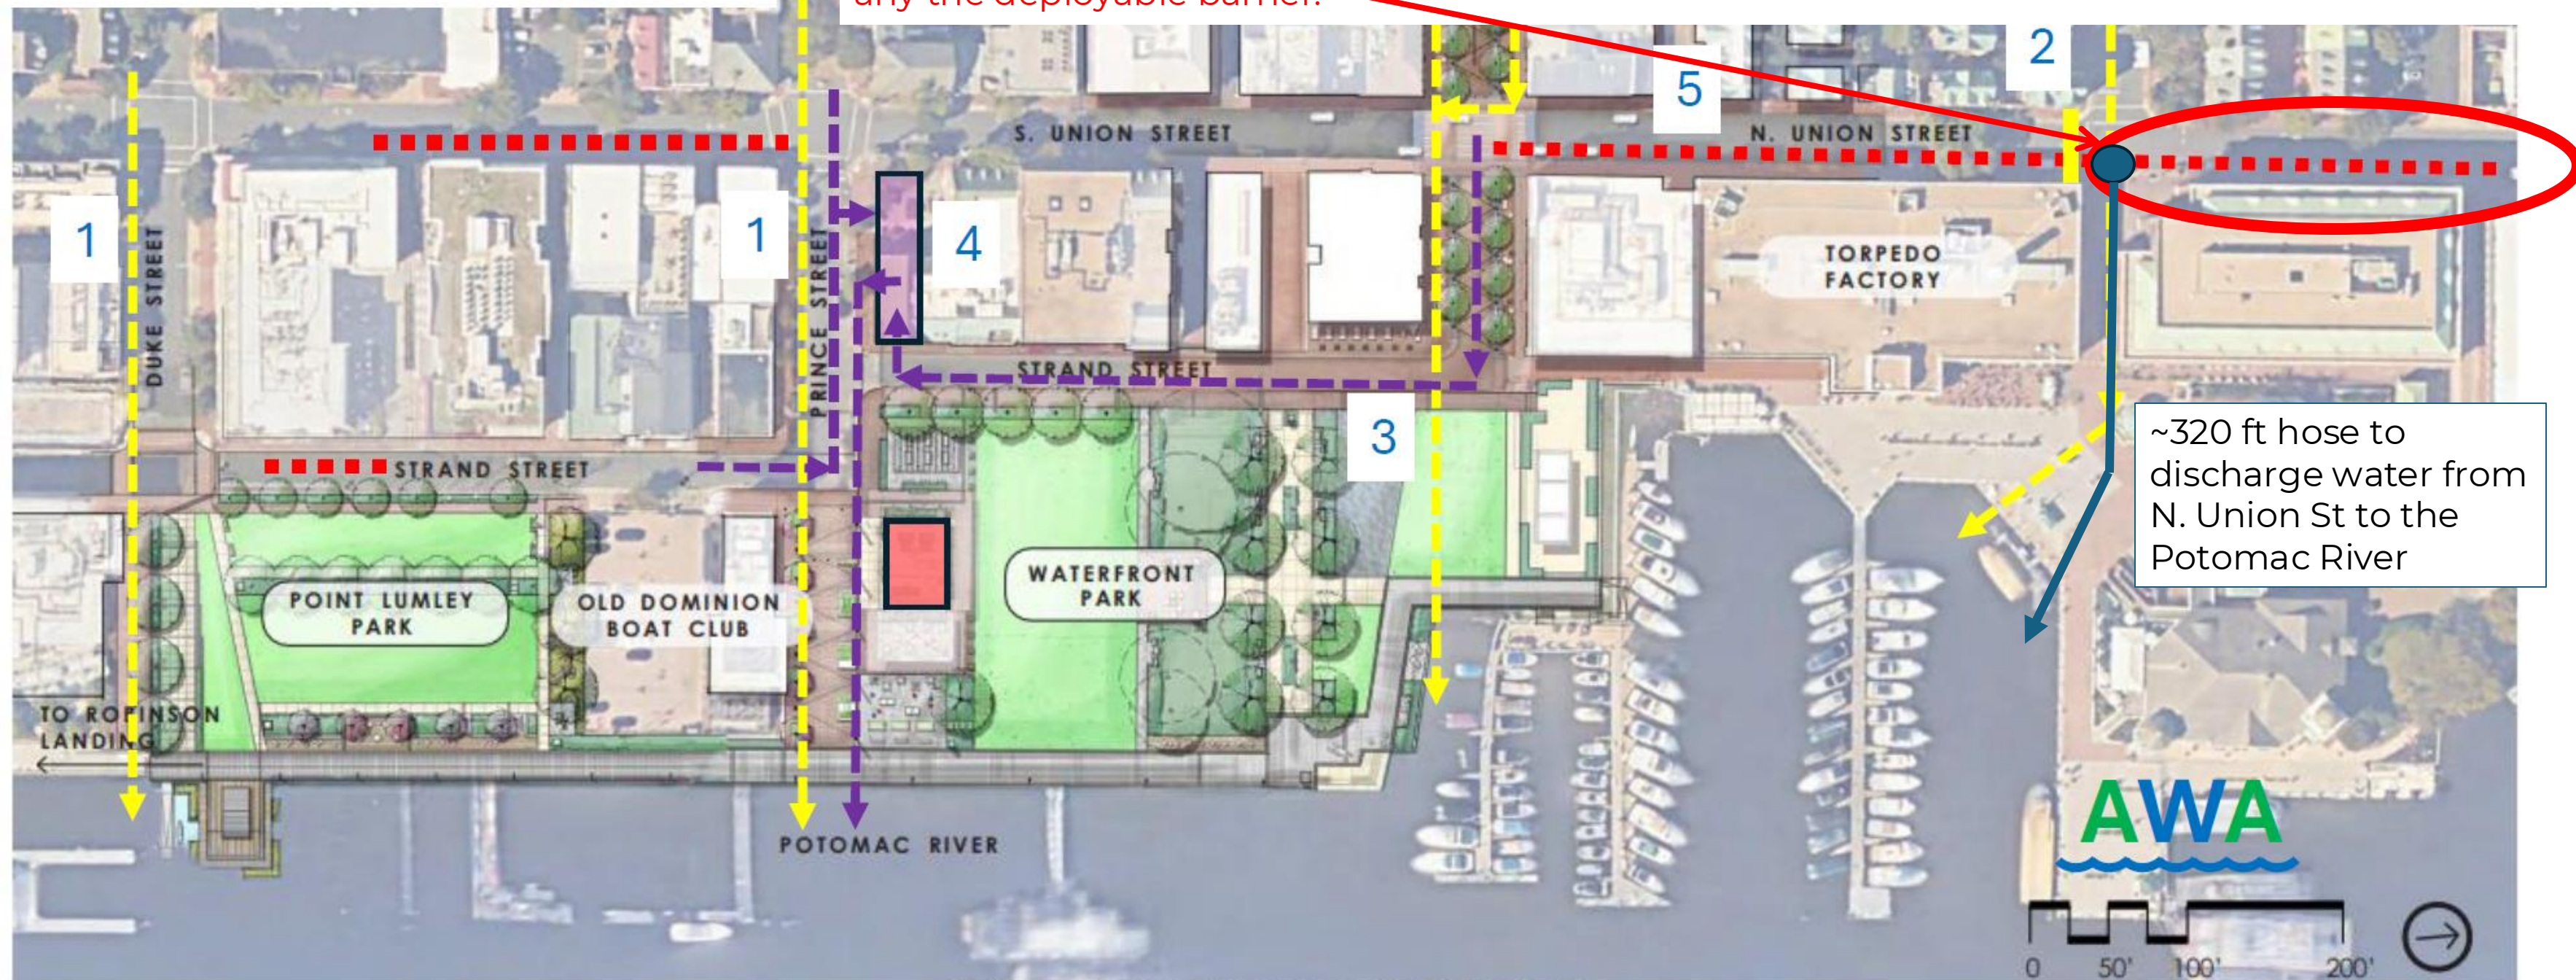

OVERALL PROJECT CONCEPT PLAN





# Project Information & Updates

▶ Participate in upcoming Business-Owner Stakeholder Meetings


▶ <https://www.alexandriava.gov/Waterfront>

▶ Email Project Manager: [Matthew.Landes@AlexandriaVA.gov](mailto:Matthew.Landes@AlexandriaVA.gov)

▶ Signup for Updates and Newsletter:



▶ Signup for Alexandria eNews:

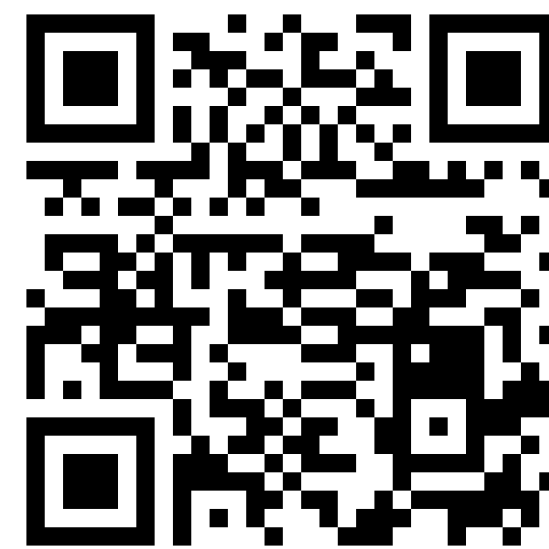


▶ Go To Planning & Zoning category

▶ Select "Waterfront Planning"





# Aging & Failing Infrastructure

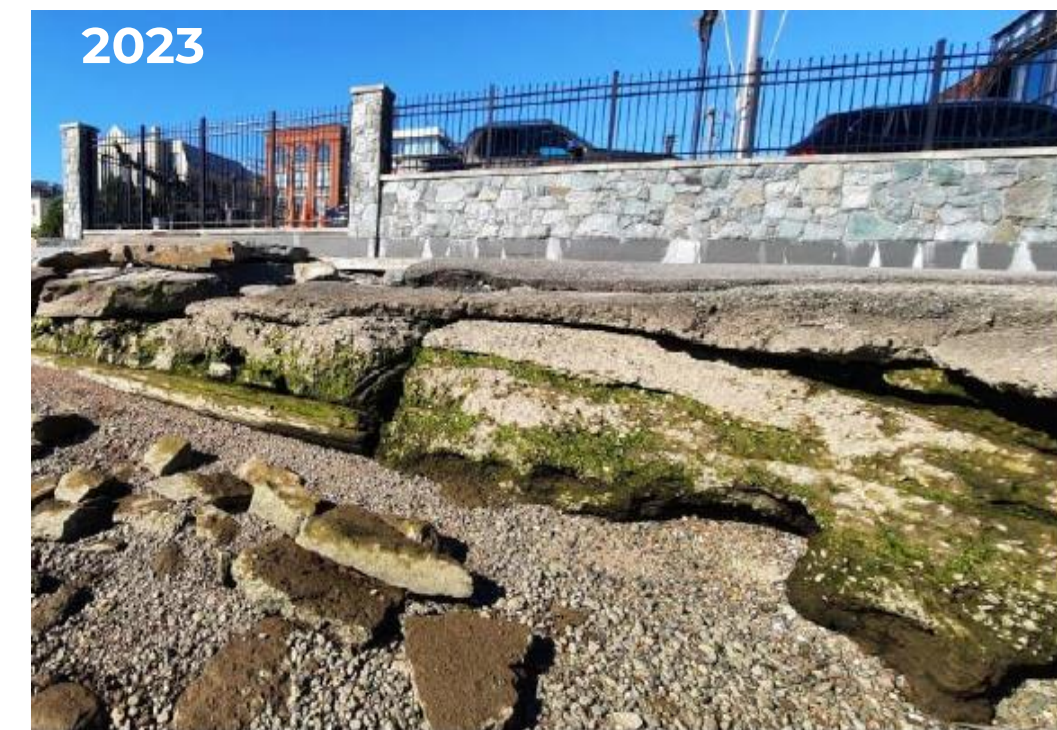



# Riverine Overtopping & Flooding

Draft, Deliberative, Pre-Decisional





# The Number of Overtopping Events Continues to Increase

<u>Potomac River Surface Elevation</u> Flooding Analysis Over Time At Prince Street/Waterfront	<u>Prince Street-End</u> (Elev. 2.4)	<u>Bulkhead at Waterfront</u> (Elev. 3.0)
In the Last 20 Years, we've seen an average of ....	145 events/yr	37 events/yr
In the Last 5 Years, we've seen an average of ....	185 events/yr	48 events/yr
In the Last 2 Years, we've seen an average of ....	194 events/yr	54 events/yr
In the Last 1 Year, we've seen...	227 events/yr	93 events/yr
By Year 2100, we anticipate...	353 events/yr	341 events/yr